


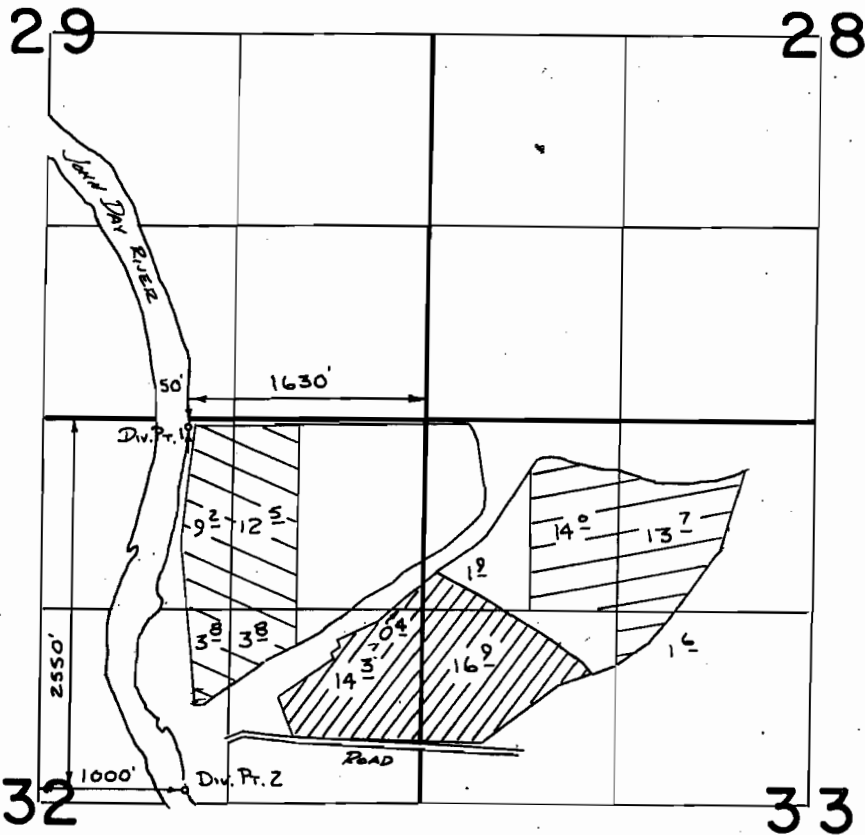


T. 7S., R. 19E., W.M.



SCALE 1" = 1320

-  T-4752
-  T-4751
-  P# 44315

FINAL PROOF SURVEY

UNDER

TRANSFERS 4751, 4752, 5295

Application No. **58592** Permit No. **44315**
 IN NAME OF

WILLIAM J. BOWERMAN JR.

Surveyed 5-12 1987, by V.L. Church