


RECEIVED

SEP 14 1998

WATER RESOURCES DEPT.
SALEM, OREGON

T.23S. R.33E., W.M

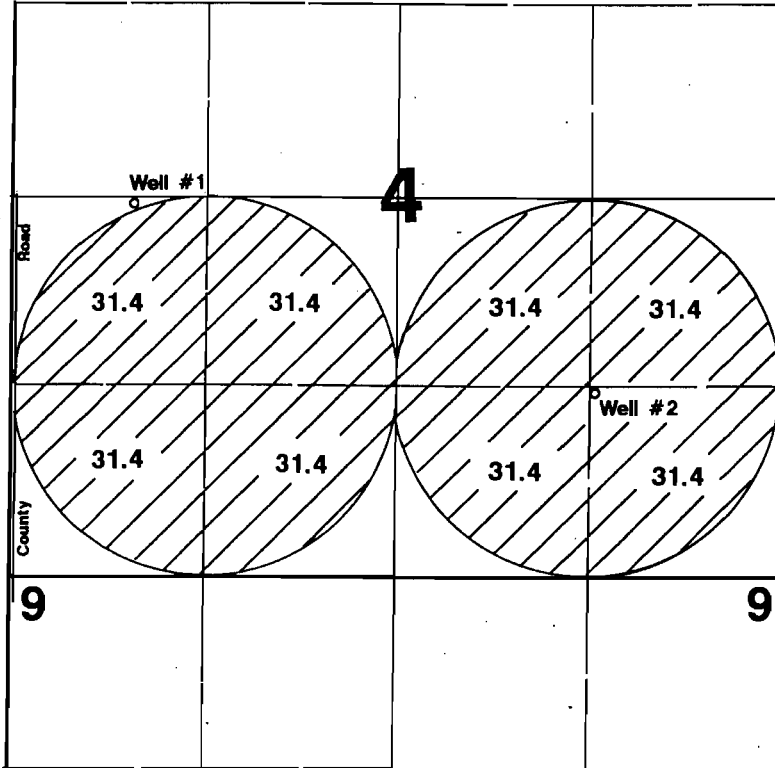

1" = 1320'



Area Irrigated

Well #1 located 80'S & 815'E from W1/4 corner of Section 4.
 Well #2 located 1330'S & 4018'E from W1/4 corner of Section 4.

Final Proof Survey

Application #: G-13025 Permit #: G-11605

In Name Of

C.T. Christie

Surveyed on July 10, 1998 by JM Schuette

This Map Was Prepared For The Purpose Of Identifying The
 Location Of A Water Right Only And Is Not Intended To Provide
 Legal Dimensions Or Location Of Property Ownership Lines.

