


North

West

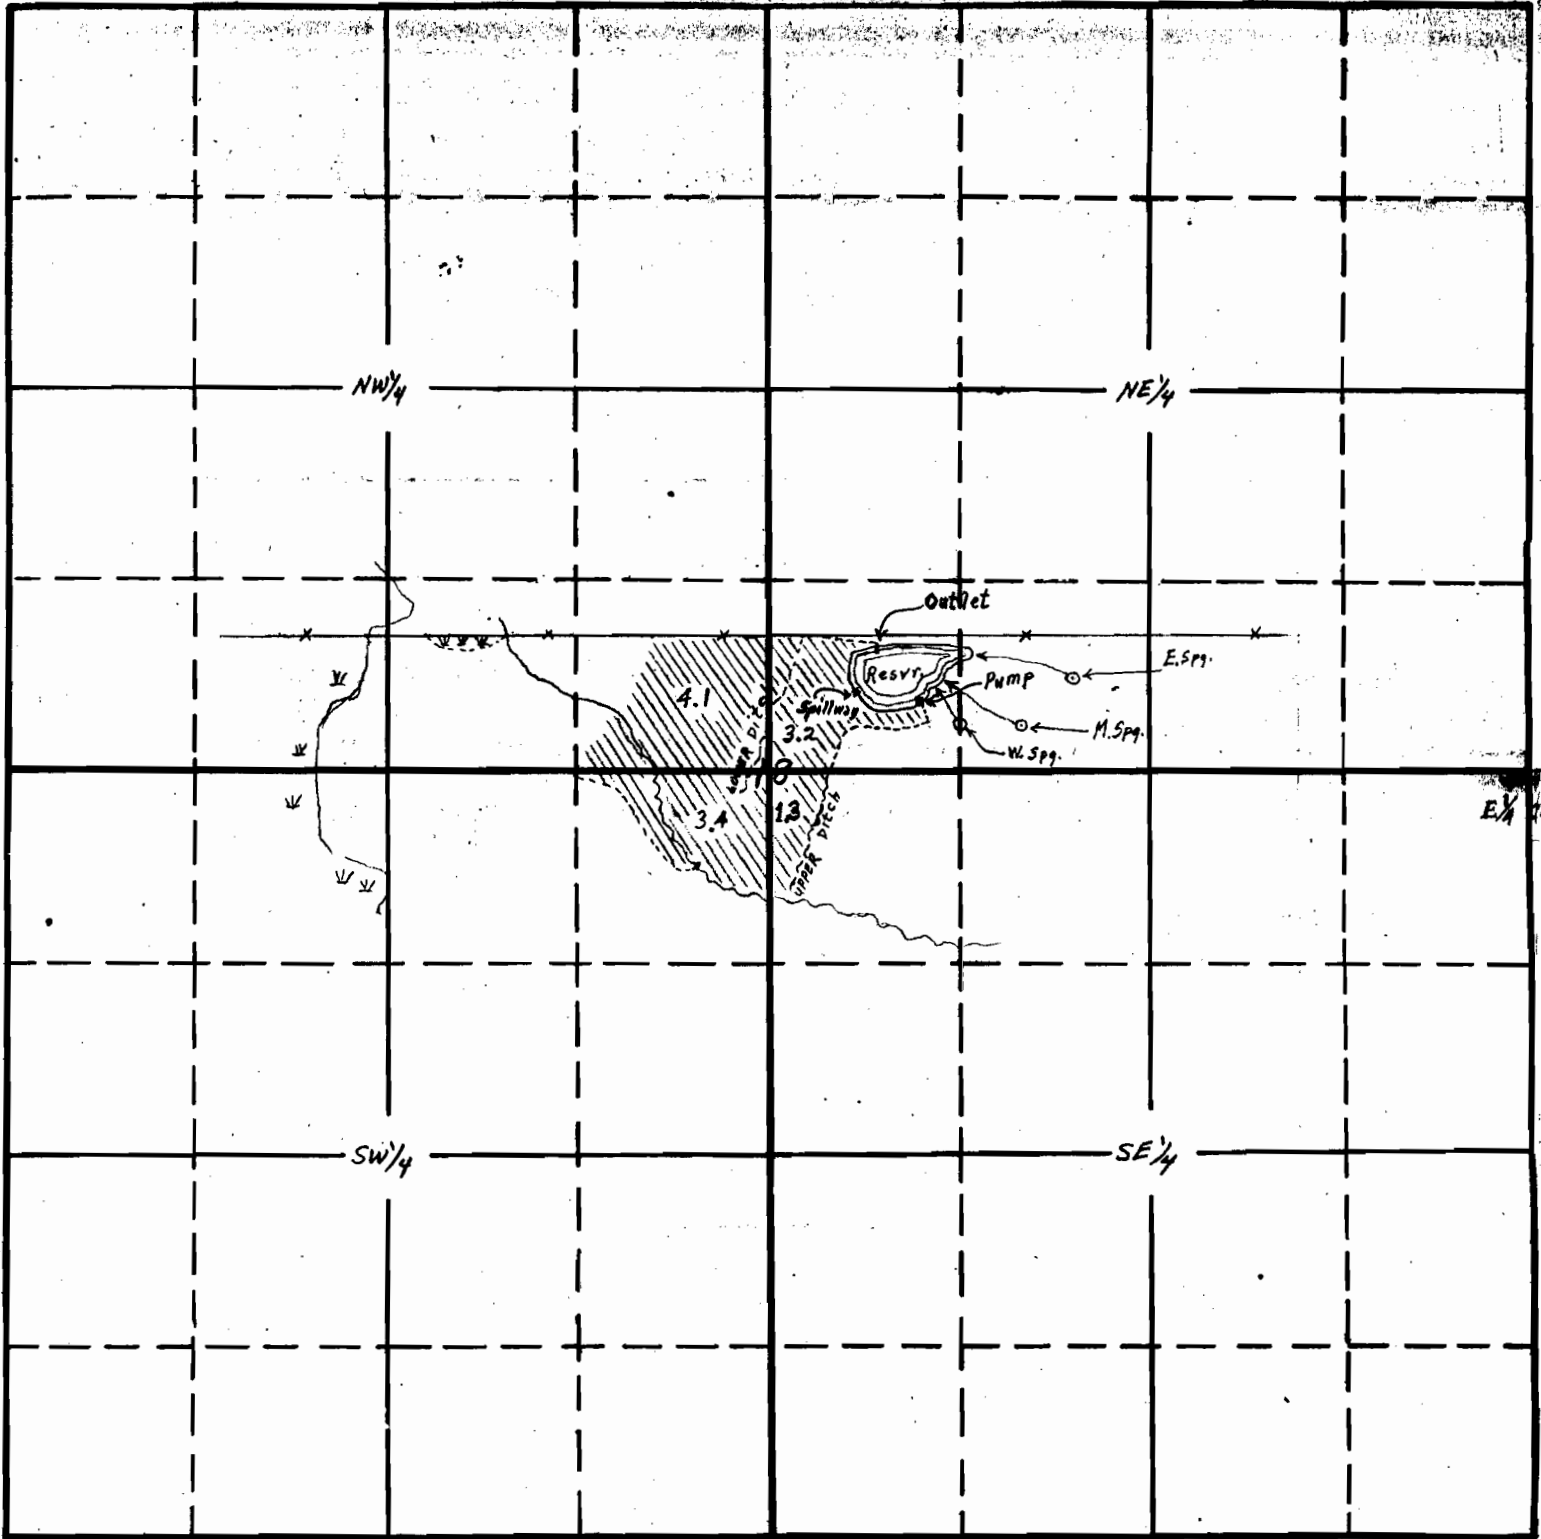

EA

A. E. BROCKWAY

South

PLANE TABLE SURVEY - MADE 4-1-53
D. L. Hendrix
Watermaster Dist. #15

APPLICATION No. 23743
PERMIT No.