

DISCLAIMER

This map was compiled by Geo-Spatial Solutions, Inc. (Bend, OR) using a variety of data sources. Data is believed to be accurate. However, a degree of error is inherent in all maps. This map is distributed "AS-IS" without warranties of any kind, either expressed or implied, including but not limited to warranties of suitability to a particular purpose or use. This map is intended for use only at the published scale. Reproduction is prohibited.

MAP CONTACT

Geo-Spatial Solutions, Inc.
P.O. Box 335
Bend, OR 97709
www.geospatial-solutions.com

DISTRICT CONTACT

Swalley Irrigation District
Jan Lee, Manager
84672 Cook Ave
Bend, OR 97701

DATA SOURCE(S)

Deschutes County
Swalley Irrigation District
Geo-Spatial Solutions, Inc.


SOFTWARE

ArcGIS® 9.2 and Windows XP


DATE CREATED

August 2008

3

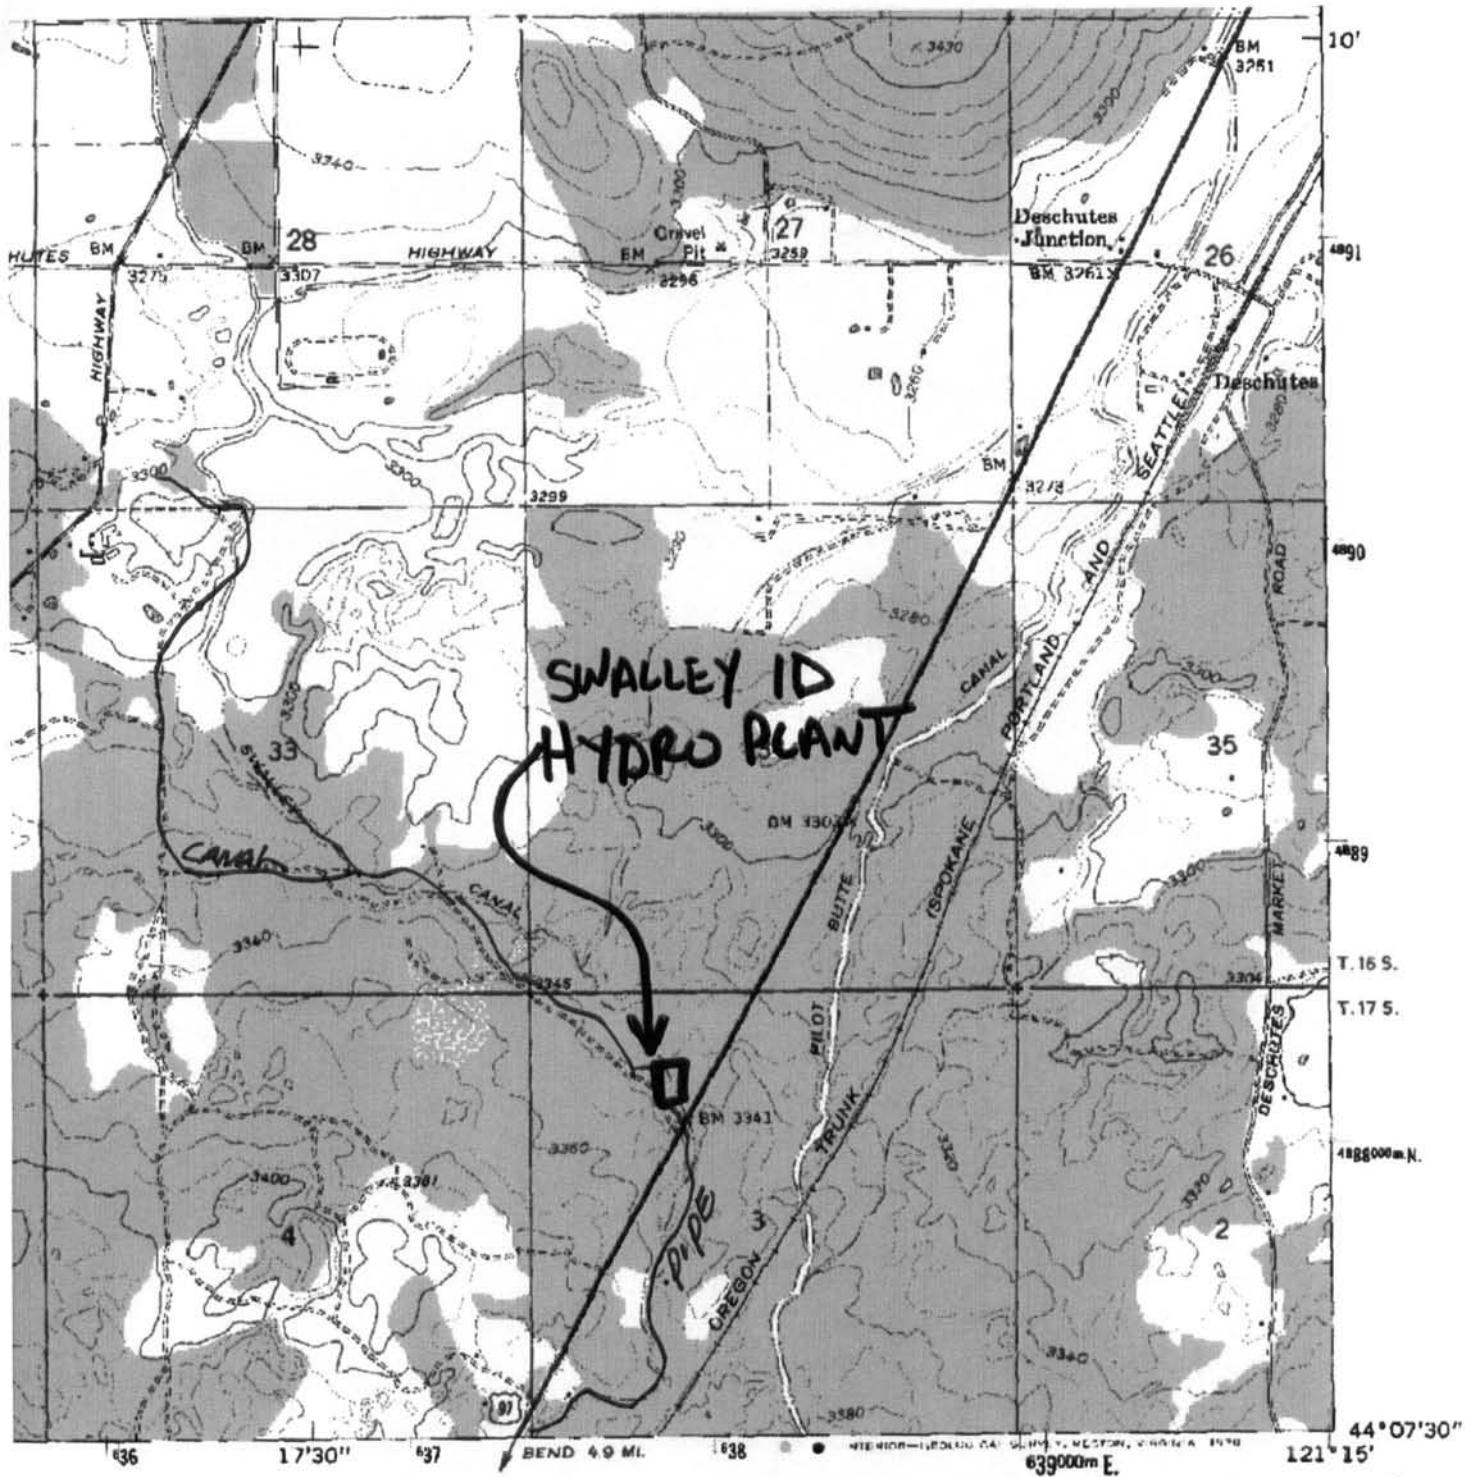

SWALLEY ID
HYDRO PLANT

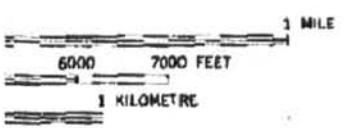

ROAD CLASSIFICATION

Heavy-duty ————— Light-duty ······

Medium-duty - - - - - Unimproved dirt - · - · - ·

U.S. Route

TUMALO, OREG.
N4407.5- W12115/7.5

1962

AMS 1772 III N&E SERIES V892
PUBLISHED 1962

IRS
929

STANDARDS
OR RESTON, VIRGINIA 22092
AVAILABLE ON REQUEST

