


T. 34 S., R. 8 W., W.M.

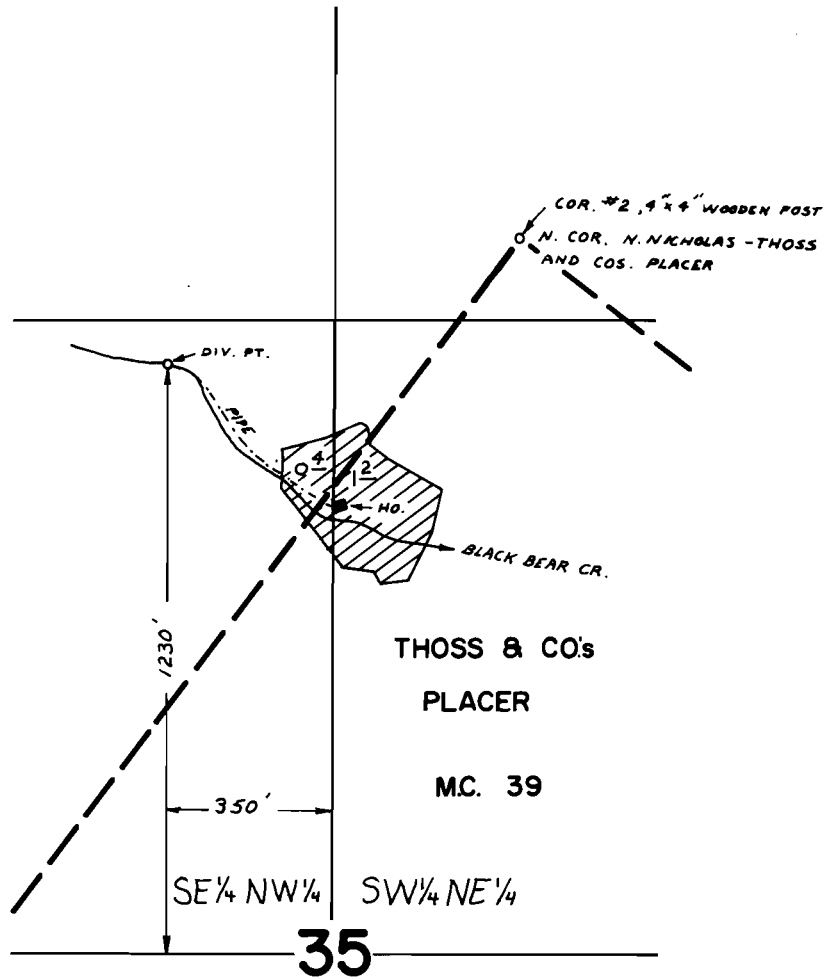

SCALE: 1" = 400 FT.

FINAL PROOF SURVEY UNDER

Application No. 52274 Permit No. 39338
IN NAME OF

LUCY A. & RELF L. PRICE III

Surveyed AUG. 14 1979, by B. SUND