



FINAL PROOF SURVEY UNDER TRANSFER 7999 & 8000

PERMIT NO. R-5488, CERTIFICATE NO. 41352 & PERMIT NO. ~~12007~~ 12207, CERTIFICATE NO. 11926

IN THE NAME OF WILLAMETTE INDUSTRIES, INC.
LOCATED IN

SECTIONS 29 & 32
T.13 S., R.1 E., W.M.
LINN COUNTY, OREGON

SCALE: 1"=1320'-0"

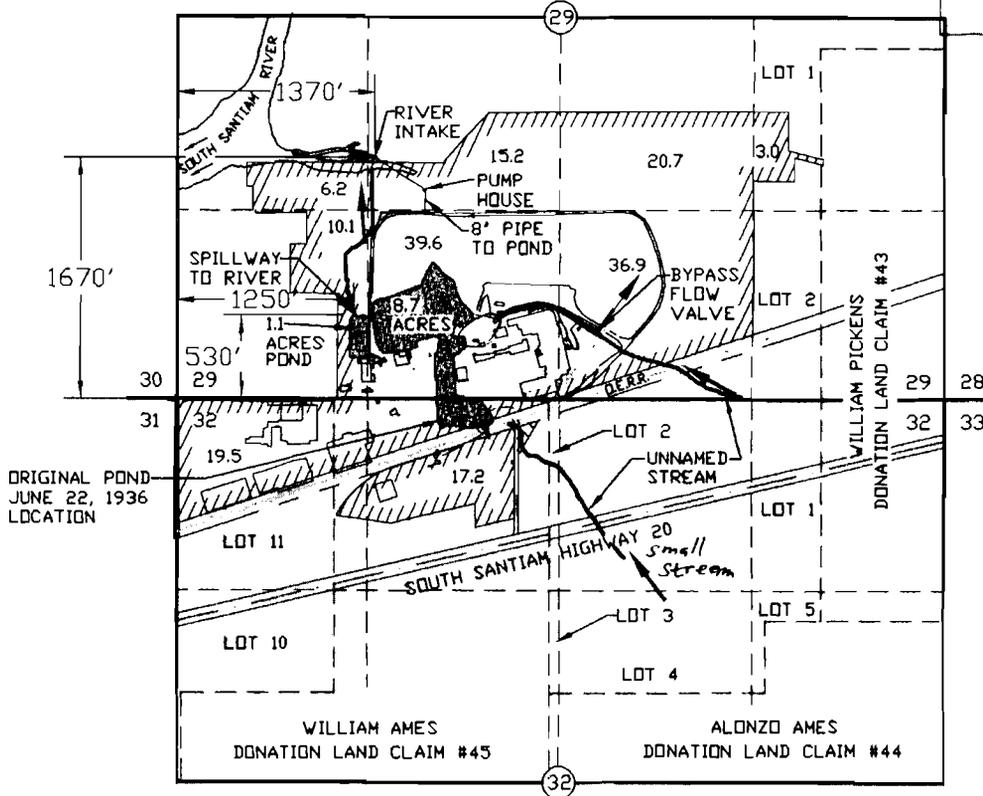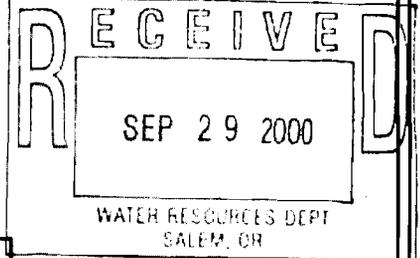


LEGEND:

- = SECTION LINES
- - - - - = FORTY LINES
- - - - - = DONATION LAND CLAIM LINES
- /////// = BOUNDARY OF ACREAGE/OWNERSHIP

ACREAGE SUMMARY

SECTION 29	NW 1/4, SW 1/4	6.2 ACRES
	SW 1/4, SW 1/4	10.1 ACRES
	NE 1/4, SW 1/4	15.2 ACRES
	SE 1/4, SW 1/4	39.6 ACRES
	NW 1/4, SE 1/4	20.7 ACRES
	SW 1/4, SE 1/4	36.9 ACRES
	NE 1/4, SE 1/4	3.0 ACRES
SECTION 32	NW 1/4, NW 1/4	19.5 ACRES
	NE 1/4, NW 1/4	17.2 ACRES

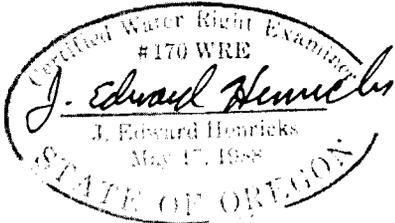

*Permit no. correction and
small stream designation (associated
with Permit 12207) by WRD staff.
January 13, 2010. BR*

I J. EDWARD HENRICKS, BEING DULY SWORN AS A WATER RIGHT EXAMINER LICENSE NO. 170, HAVE PREPARED THIS MAP FOR WILLAMETTE INDUSTRIES, INC. ON THIS 18th DAY OF SEPTEMBER 2000. THE AREAS HATCHED REPRESENT THE ACREAGES PUT TO BENEFICIAL USE FOR STORAGE FOR MANUFACTURING AS PER TRANSFERS 7999 AND 8000.

ONLY DOCUMENTS STAMPED WITH
RED INK ARE ORIGINALS.

PREPARATION OF THIS MAP IS FOR THE PURPOSE OF IDENTIFYING THE LOCATION OF THE WATER RIGHT ONLY AND HAS NO INTENT TO PROVIDE DIMENSIONS OR LOCATION OF PROPERTY OWNERSHIP LINES.