

T6N, R35E, S23, WM
Umatilla County

23

STATE HWY 339

E Prong Little W W River

FERNDALE ROAD

RECEIVED

SEP 29 2009

WATER RESOURCES DEPT
SALEM, OREGON

W Branch W Crockett Branch

POA 1
(old well)

POA 2
(new well)

TL 2200

TL 2202

4.3

5.0

9.6

TOTAL
18.9 ac

S/4 Corner

22

23

27

26

Points of Appropriation

POA 1 (old well) is gravel groundwater well located 750 feet N and 415 feet W from S/4 Corner of S23. Well Log UMAT 4416. No flowmeter present nor required.

POA 2 (new well) is alluvial groundwater well located 550 feet N and 720 feet W from S/4 Corner of S23. Well Log UMAT 56058. Flowmeter at same location.

Conveyance

Water conveyed with 3-inch buried mainline and applied to grass pasture with sprinklers on aluminum handline.



Place of Use (supplemental)

Irrigation of 5.0 acres (Permit G-5460)



Place of Use (primary)

Irrigation of 4.3 acres (Permit G-5460)



Place of Use (primary)


Irrigation of 9.6 acres (Permit G-6153)



1 inch = 400 feet

The purpose of this map is to identify the location of a water right. It is not intended to provide information regarding the location of property ownership boundary lines.

FOUNTAINHEAD
1204 Alvarado Terrace
Walla Walla, WA 99362
(509) 529-2646 phone

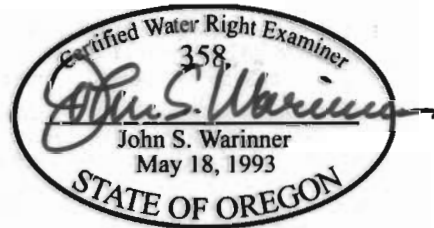

**CLAIM OF BENEFICIAL USE
Transfer 10056**

in the name of
RICK & ROBIN TRUMBULL

Revised 25 SEP 2009