

T6N, R35E, S23, WM  
Umatilla County

23

STATE HWY 339

E Prong Little W River

FERNDALE ROAD

RECEIVED

SEP 29 2009

WATER RESOURCES DEPT  
SALEM, OREGON

W Branch W Crockett Branch

POA 1  
(old well)

POA 2  
(new well)

TL 2200

TL 2202

4.3

5.0

9.6

TOTAL  
18.9 ac

S/4 Corner

22 23

27 26

**Points of Appropriation**

POA 1 (old well) is gravel groundwater well located 750 feet N and 415 feet W from S/4 Corner of S23. Well Log UMAT 4416. No flowmeter present nor required.

POA 2 (new well) is alluvial groundwater well located 550 feet N and 720 feet W from S/4 Corner of S23. Well Log UMAT 56058. Flowmeter at same location.

**Conveyance**

Water conveyed with 3-inch buried mainline and applied to grass pasture with sprinklers on aluminum handline.



**Place of Use (supplemental)**

Irrigation of 5.0 acres (Permit G-5460)



**Place of Use (primary)**

Irrigation of 4.3 acres (Permit G-5460)



**Place of Use (primary)**


Irrigation of 9.6 acres (Permit G-6153)



1 inch = 400 feet

The purpose of this map is to identify the location of a water right. It is not intended to provide information regarding the location of property ownership boundary lines.

FOUNTAINHEAD  
1204 Alvarado Terrace  
Walla Walla, WA 99362  
(509) 529-2646 phone

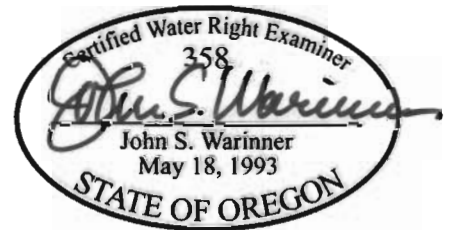

**CLAIM OF BENEFICIAL USE  
Transfer 10056**

in the name of  
RICK & ROBIN TRUMBULL

Revised 25 SEP 2009