


# T. 16 S., R. 4 W., W.M.

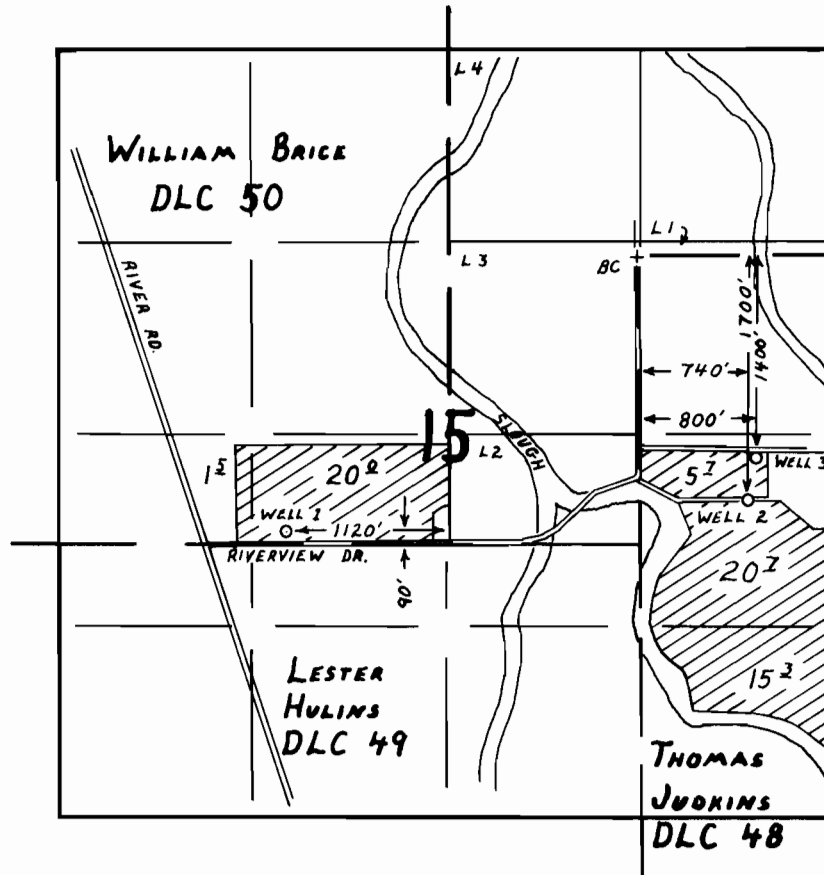

## FINAL PROOF SURVEY

UNDER

Application No. G-8994 Permit No. G-11095  
IN NAME OF

JOHN T. BRICE

Surveyed MAY 21, 1992, by R.W. Klassen