


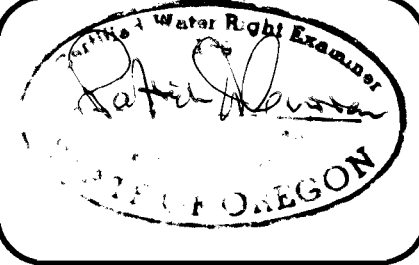
22 | 23  
27 | 26

SEC 23 T5S, R1E, W.M.

  
SCALE: 1" = 400'

1180PL01

**CLAIM MAP**  
of  
**BENEFICIAL USE**  
**R-11223**



**CURRAN-McLEOD, INC.**  
**CONSULTING ENGINEERS**  
6655 S.W. HAMPTON ST., SUITE 210  
PORTLAND, OREGON 97223  
PHONE (503) 684-3478