

T.3.S., R.39.E., W.M.
UNION COUNTY, OREGON

RECEIVED

JUN 29 1998

WATER RESOURCES DEPT.
SALEM, OREGON

SCALE:
1" = 1320'

TABLE OF IRRIGATION AREAS

T.3.S., R.39.E., W.M., UNION COUNTY
TAX LOT 3000

SECTION 9		
SW 1/4 OF SE 1/4	32 AC.	64 ACRES
SE 1/4 OF SE 1/4	32 AC.	
TOTAL		64 ACRES

SECTION 16			
NW 1/4 OF NE 1/4	40 AC.	305 ACRES	
NE 1/4 OF NE 1/4	40 AC.		
SW 1/4 OF NE 1/4	40 AC.		
SE 1/4 OF NE 1/4	40 AC.		
NW 1/4 OF SE 1/4	40 AC.		
NE 1/4 OF SE 1/4	40 AC.		
SW 1/4 OF SE 1/4	32.5 AC.		
SE 1/4 OF SE 1/4	32.5 AC.		
TOTAL			305 ACRES


TOTAL AREA IRRIGATED = 369 ACRES

LEGEND

● WELL LOCATION - 3260' NORTH AND 1335' WEST FROM THE SE CORNER OF SECTION 16, T.3S., R.39E.

NOTE: THIS MAP IS FOR THE PURPOSE OF LOCATING A WATER RIGHT ONLY AND IS NOT INTENDED TO PROVIDE LEGAL DIMENSIONS OR LOCATIONS OF PROPERTY LINES.

DATE OF SURVEY: 6-19-98

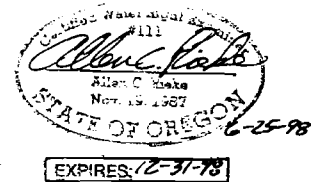

APPLICATION #G-13987 PERMIT #G-13166

CLAIM OF BENEFICIAL USE MAP

FOR: CONLEY FARMS
61050 CONLEY ROAD
COVE, OREGON 97824

FIGURE

1

