

T.38S., R.11 1/2 E., W.M.

Application No. G-10743


Permit No. ✓

G 9882

RECEIVED

SEP 3 1982

WATER RESOURCES DEPT
SALEM, OREGON

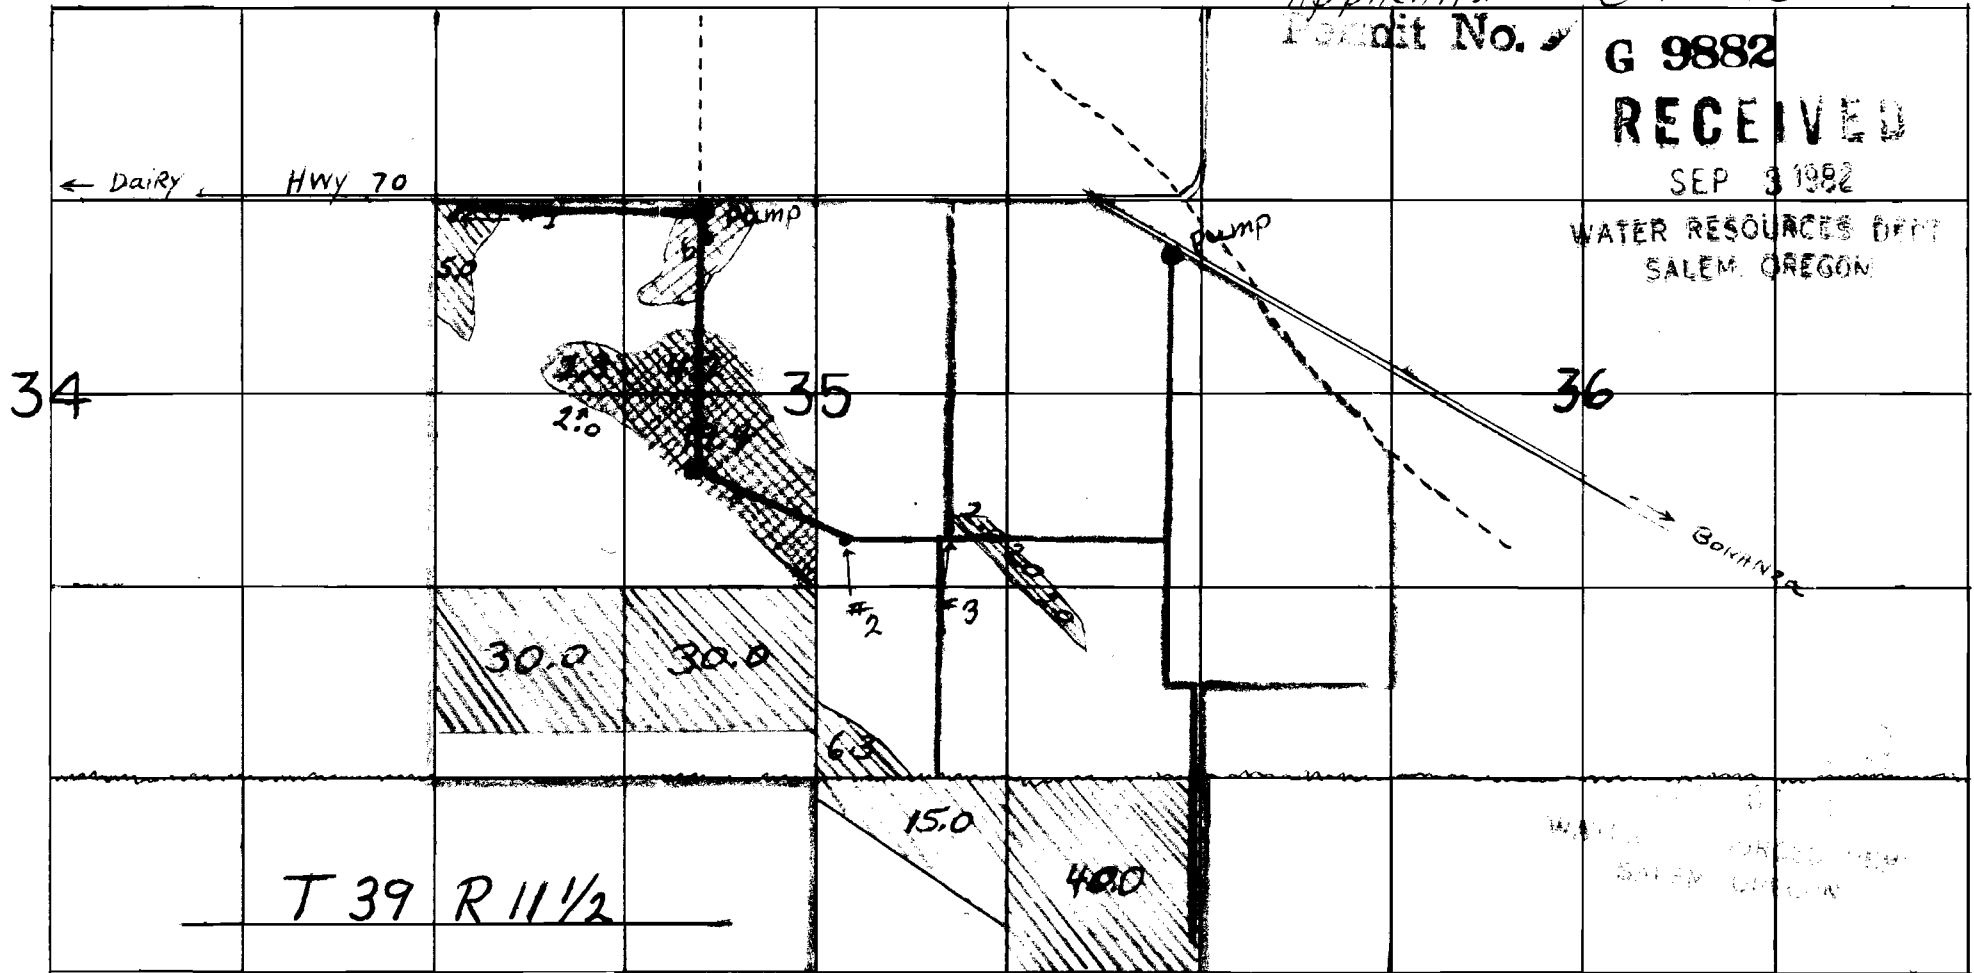

- #1 well is located 105' S + 106' E FROM North west corner of S/W 1/4 N/W 1/4 - sect 35
- #2 well is located 330' N + 220' E FROM S/W corner of N/W 1/4 - S/E 1/4 - sect 35
- #3 well is located 355' N + 390' W FROM S/E corner of N/W 1/4 - S/E 1/4 - sect 35

all Pumps are Hooked Together By the mainline
To make one complete system

- 1" = 1,320'
- HORSEFLY IRRIGATION DITCH
- ▨ PRIMARY
- ▩ SECONDARY - Supp.
- DRAIN DITCH
- MAIN LINE
- HORSEFLY WATER ENTERS SYSTEM