


T7S & T8S, R3W, WM

MARION COUNTY

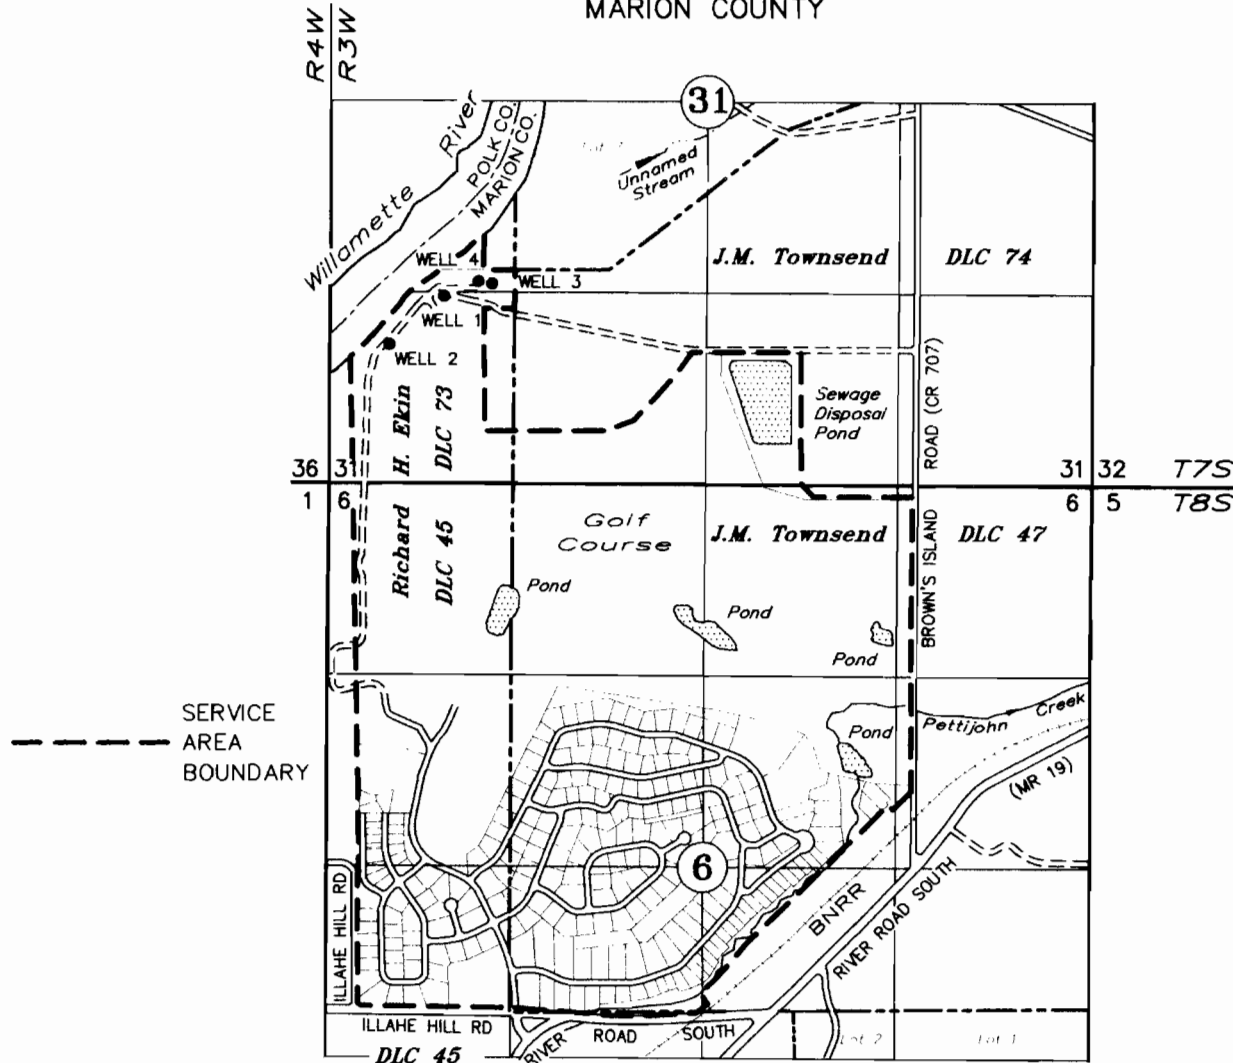

WELL 1: 187' S & 498' W OF NW COR J.M. TOWNSEND DLC 74
 WELL 2: 517' S & 870' W OF NW COR J.M. TOWNSEND DLC 74
 WELL 3: 102' S & 189' W OF NW COR J.M. TOWNSEND DLC 74
 WELL 4: 83' S & 262' W OF NW COR J.M. TOWNSEND DLC 74

WELL 1 METER: INSIDE WELL 1 PUMP HOUSE
 WELL 2 METER: 10' WEST OF WELL 1 PUMP HOUSE IN FENCED AREA
 WELLS 3 & 4 METERS: 16' SOUTH OF WELL 4

FINAL PROOF SURVEY

Application No. G-16164 Permit No. G-15833

ILLAHE ESTATES WATER SYSTEM

SEPTEMBER 30, 2009
 SCALE: 1" = 1320'



NOTE: This map is for the purpose of identifying the location of water rights and has no intent to dimension or locate property ownership lines.

EXPIRES 12-31-09