


JUN 28 1924

SAVED BY J. H. HOFFMAN

N

T9S, R44E, W.M., ORE.

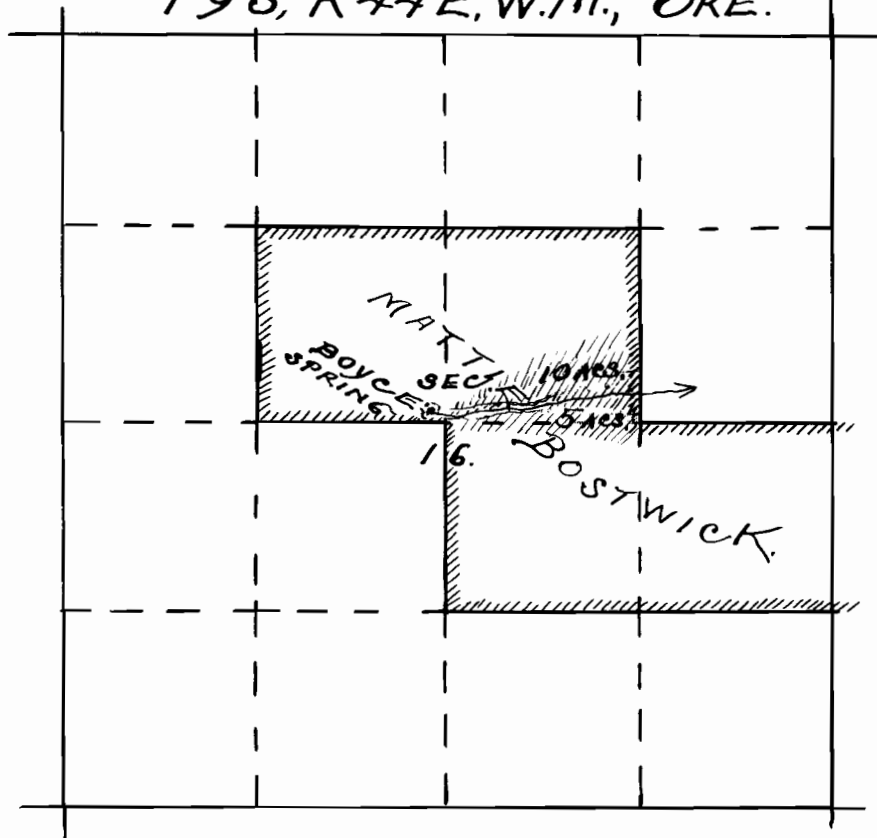

## SKETCH

SHOWING

THE LOCATION OF THE  
LANDS IRRIGATE FROM THE  
BOYCE SPRING ON THE MAT-  
TIE BOSTWICK LAND IN SEC.  
16, T9S, R44E, W.M., BAKER CO.,  
OREGON.

SCALE, ONE INCH = 20.00 CHS.

PLAT MADE JUNE 28, 1924.

*Ira L. Hoffman.*  
County Surveyor.

**CERTIFICATE OF REGISTERED  
PROFESSIONAL ENGINEER.**

I, IRA L. HOFFMAN OF BAKER,  
ORE., DO HEREBY CERTIFY THAT  
THIS MAP WAS MADE FROM DA-  
TA SUPPLIED BY JOHN W. BOYCE,  
FORMER OWNER OF THE MAT-  
TIE BOSTWICK LAND AND THAT  
IT CORRECTLY REPRESENTS THE  
SAID DATA THEREON



6385