90684

T.35S., R.7E., W.M.

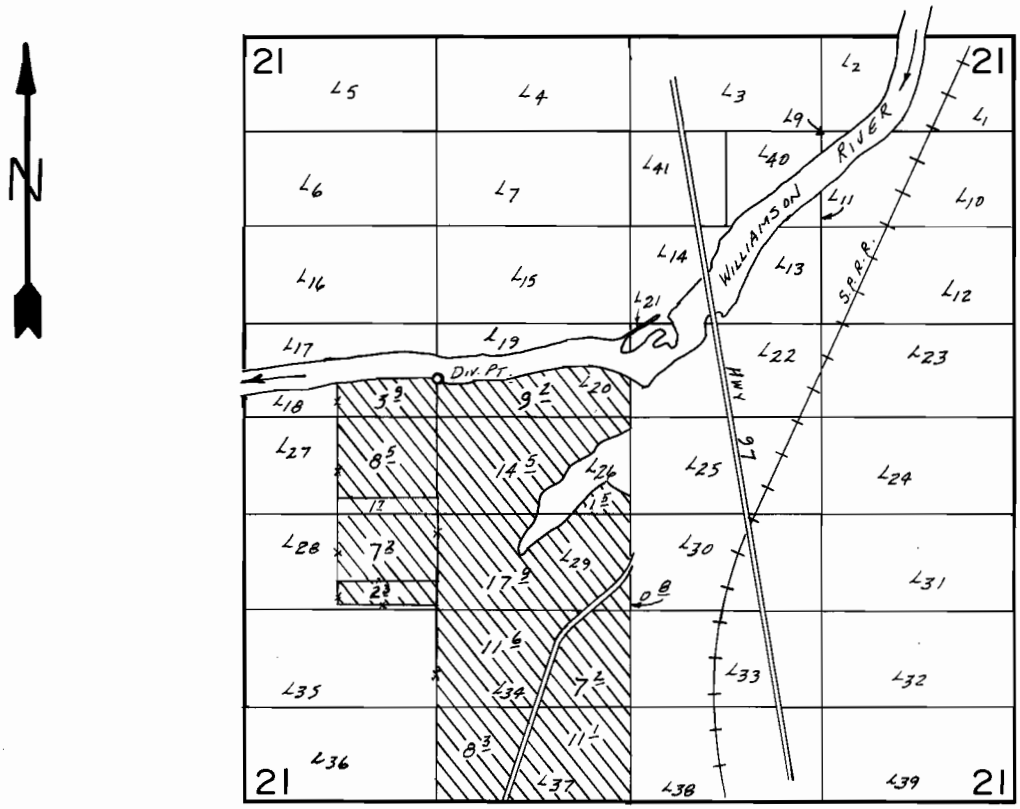

DIV. PT. LOC.: 2900'N. & 1320'E. FROM SW COR. SEC. 21.

SCALE: 1" = 1320'

FINAL PROOF SURVEY

UNDER

Application No. 59451 **Permit No.** 45058

IN NAME OF

KEITH C. CALDWELL

Surveyed Sept. 14 **19** 86, **by** R.W. BISHOP

1-29-87
RWB
Rev. 6-14-93

CNO-1JJ-126
PTS 1986D