


T. 88&9S., R. 25E., W.M.

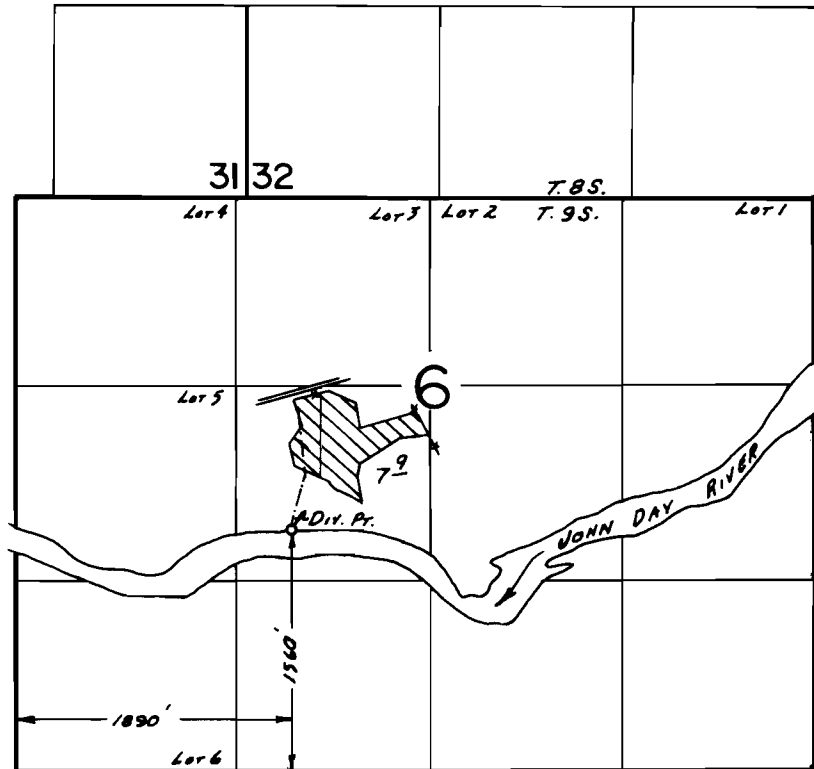

FINAL PROOF SURVEY
UNDER

Application No. 53835.. Permit No. 40183.....

IN NAME OF

William I. Chopman

.....*Albert M. F. Shirley A. Garber*.....

Surveyed JUNE 25. 19.80., by S.C. BROWN.....