


T.16S., R.24E., W.M.

G-12761 PERMIT

FINAL PROOF SURVEY

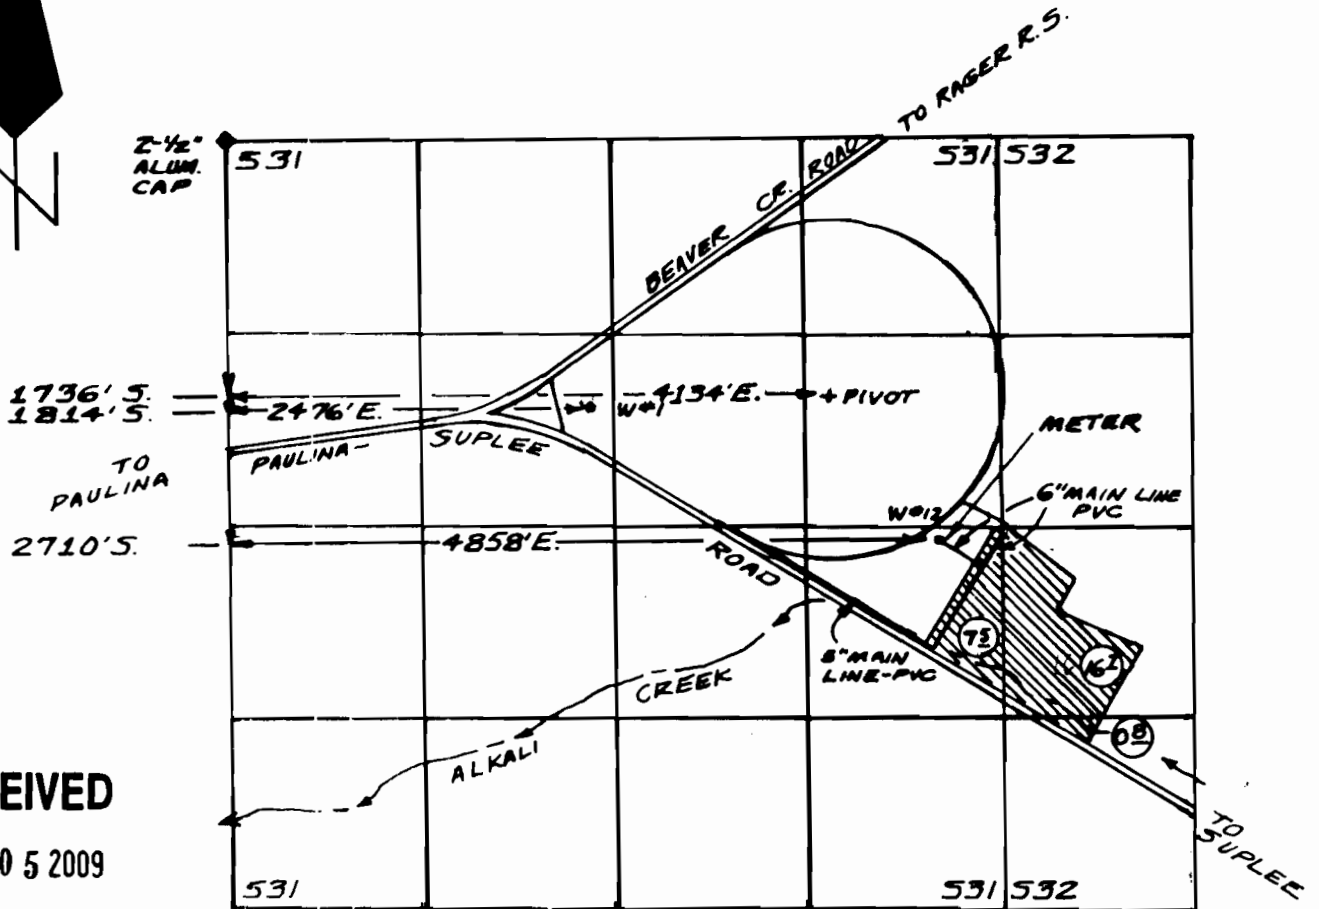

RECEIVED

NOV 05 2009

WATER RESOURCES DEPT
SALEM, OREGON

SURVEY NOTE

THE PREPARATION OF THIS MAP IS FOR THE PURPOSE OF IDENTIFYING THE LOCATION OF THE WATER RIGHT ONLY AND HAS NO INTENT TO PROVIDE DIMENSIONS OR LOCATIONS OF PROPERTY OWNERSHIP LINES.

REVISED 10-27-2009

PREPARED FOR


BEDORTHA RANCHES, INC.
P.O. BOX 14
PAULINA, OR 97751
(541) 477-3118

LEGEND

- W# WELL NUMBER
- IRRIGATED
- ACREAGE

Renew 12/31/09

ARMSTRONG SURVEYING
& ENGINEERING, INC.
378 EAST SECOND STREET
PRINEVILLE, OR 97754
(541) 447-7791

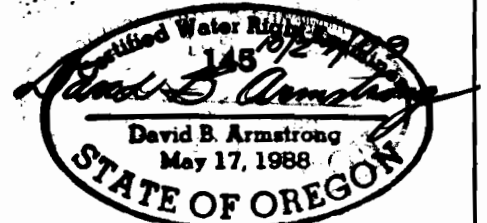

SCALE: 1" = 1320'

APRIL 21, 1999

W.O. 99-1255