


T 23 S, R 32 E, WM

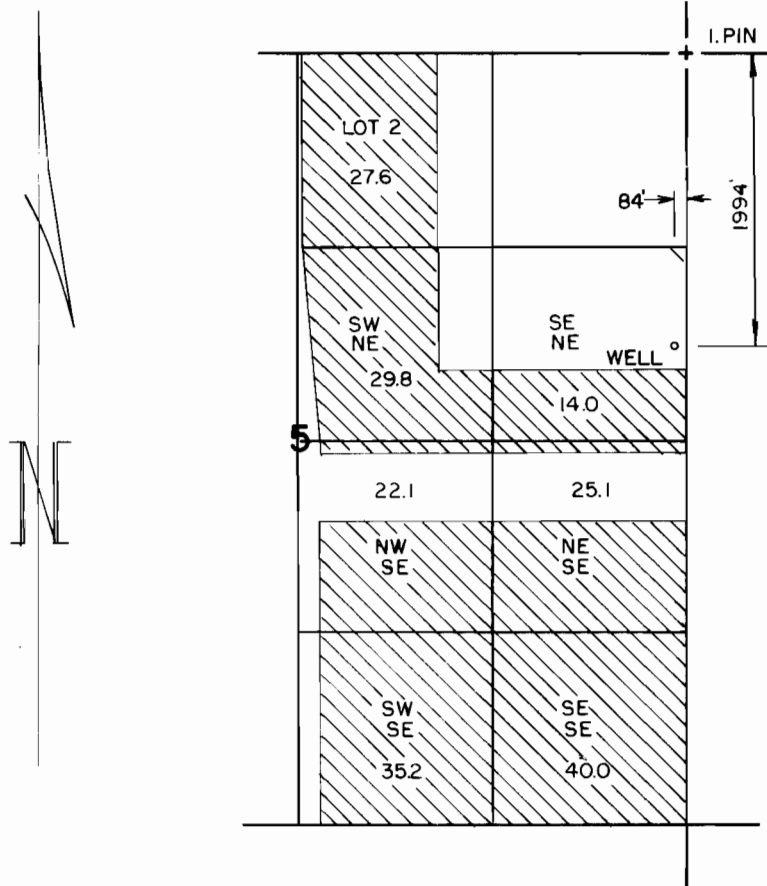

RECEIVED

AUG 26 1998

WATER RESOURCES DEPT
SALEM, OREGON

THE PURPOSE OF THIS MAP IS TO
IDENTIFY THE LOCATION OF THE
WATER RIGHT. IT IS NOT INTENDED
TO PROVIDE INFORMATION RELATIVE
TO THE LOCATION OF PROPERTY
OWNERSHIP

FINAL PROOF SURVEY

UNDER
APPLICATION G-12614
PERMIT G-11810

IN THE NAME OF
DAVID REED

Scale: 4" = 1 MILE

Date: AUG. 1998

Job: 1335-98

Dsn:

Drn: CHRIS

Ckd:

MAP's

M. A. PALMER & SONS, INC.
ENGINEERING & SURVEYING
254 N. Alder - Box 61
Burns, Oregon 97720

Sht. No.

of 1

