

**Claim of Beneficial Use
Place of Use Map**
Transfer T-2490 (Permit G-1229)

LEGEND


- Place of Use (POU)
- Donation Land Claims
- TVWD Boundary
- Major Roadways
- Waterways
- Waterbodies



EXPIRES: ~~12-31-2008~~
12-31-2010
T. Ressler

DISCLAIMERS:

1. This map was prepared for the purpose of identifying the location of a water right only and it is not intended to provide legal dimensions or location of property ownership lines.
2. Under the provisions of ORS 540.510(3) the Tualatin Valley Water District may lawfully provide and use water in locations other than those described.

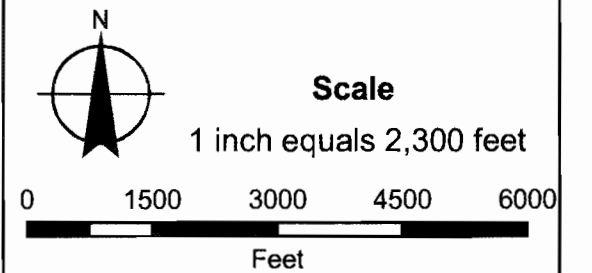

MAP NOTES:
Projection: Oregon State Plane North Zone
Datum: North American Datum of 1983
Date: November 24, 2009
Data Source: OWRD, Oregon Geospatial Clearinghouse, TVWD



0481