


T 8 S R 46 E

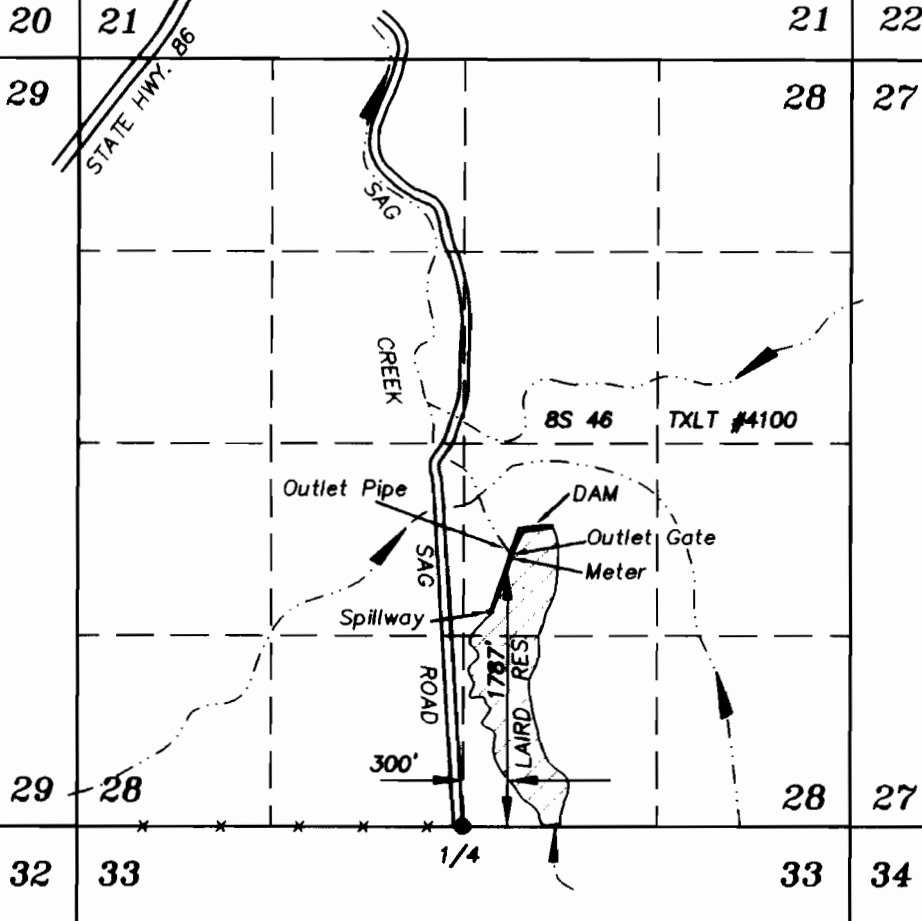

SCALE: 1"=1320'

LEGEND

- Existing Fenceline
- Roadway
- Existing Stream

RECEIVED

NOV 16 2009

WATER RESOURCES DEPT
SALEM, OREGON



October 25, 2009

**FINAL PROOF MAP OF STORED
WATER IN LAIRD RESERVOIR
FOR
PINE VALLEY LAND LLC.
(DAVID MOORE)**

BY
BAGETT - GRIFFITH & BLACKMAN
2006 ADAMS AVENUE
LAGRANDE, OREGON 97850

NOTE: The preparation of this map was for the purpose of identifying the location of the proposed water right and has no intent to provide dimensions or location of property ownership lines. Location information shown hereon was furnished by the applicant.

Application No. R- 72487

Permit Number R- 11769