


T. 8 S. R. 39 E. W.M.

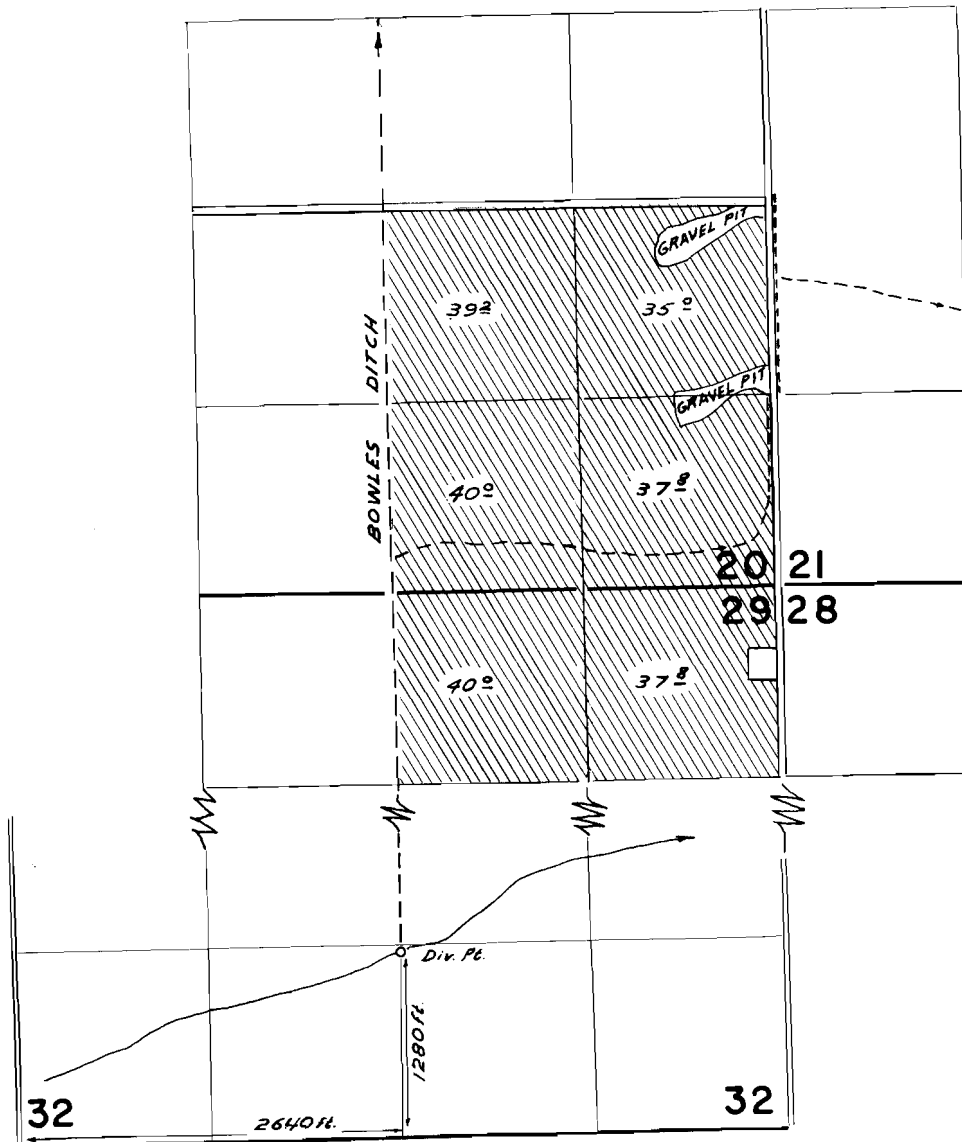

FINAL PROOF SURVEY
UNDER

Application No. 33512 Permit No. 26506
IN NAME OF

ALVIN F. MOSER

Surveyed NOV. 16, 17 1964, by C. GARDNER