


T. 12S., R. 1W., W.M.

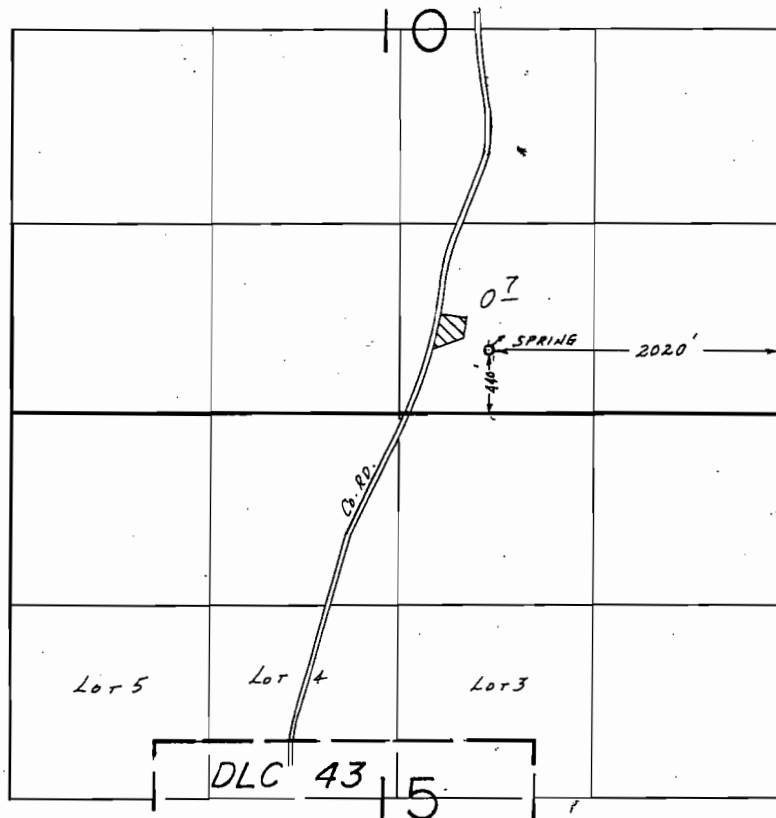

SCALE: 1" = 1320'

FINAL PROOF SURVEY

UNDER

Application No. 61773.. Permit No. 46173.....
IN NAME OF

JOE ALLEN & JOAN PHYLLIS LANG

Surveyed June 16... 1986, by B.W. BISHOP.....

11/10/86
BWB

DFM-32L-129