

FINAL PROOF SURVEY & CLAIM OF BENEFICIAL USE  
FOR  
UMATILLA NATIONAL FOREST  
SE1/4 of NW1/4, NW1/4 of NE1/4, & SW1/4 of NE1/4  
OF SECTION 8, T. 9 S., R. 34 E., W.M.  
PERMITS 51158 AND R-11346  
GRANT CO., OREGON  
OCTOBER 14, 1994

S.32 | S.33 T. 8 S.  
S. 5 | S. 4 T. 9 S.

DATUM: NAD1927  
LATITUDE: 44°49'21.22" N.  
LONGITUDE: 118°38'09.09" W.

LEGEND



SECTION CORNER



ACREAGE COVERED  
BY RESERVOIR

--- 1/16th LINE

SCALE: 1 INCH = 400 FEET



DAM SITE

RECEIVED

NOV 16 1994


WATER RIGHT  
SALEM, OREGON

SE1/4 of NW1/4  
SECTION 8

SW1/4 of NE1/4  
SECTION 8

ACREAGE COVERED BY RESERVOIR  
NW1/4 of NE1/4: 0.04 ACRES  
SW1/4 of NE1/4: 5.20 ACRES  
SE1/4 of NW1/4: 2.60 ACRES  
TOTAL: 7.84 ACRES

THIS MAP IS PREPARED FOR  
THE EXPRESS PURPOSE TO  
SHOW WATER APPROPRIATION  
AND USE. IT IS NOT  
INTENDED TO SHOW OR  
LOCATE PROPERTY OWNERSHIP  
LINES.

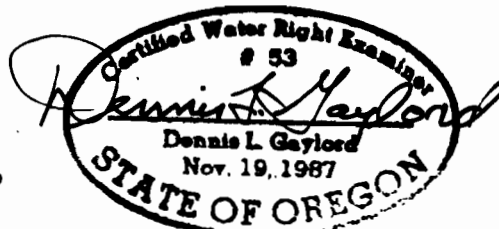

DENNIS L. GAYLORD  
CWRE NO. 53  
UMATILLA NATIONAL FOREST  
2517 S.W. HAILEY AVENUE  
PENDLETON, OR. 97801  
PHONE: (503) 278-3748

RENEWS 6/30/95