

FINAL PROOF SURVEY & CLAIM OF BENEFICIAL USE
FOR
UMATILLA NATIONAL FOREST
SE1/4 of NW1/4, NW1/4 of NE1/4, & SW1/4 of NE1/4
OF SECTION 8, T. 9 S., R. 34 E., W.M.
PERMITS 51158 AND R-11346
GRANT CO., OREGON
OCTOBER 14, 1994



S.32 | S.33 T. 8 S.
S. 5 | S. 4 T. 9 S.

DATUM: NAD1927
LATITUDE: 44°49'21.22" N.
LONGITUDE: 118°38'09.09" W.

LEGEND

- ⊙ SECTION CORNER
-  ACREAGE COVERED BY RESERVOIR
- - - 1/16th LINE

SCALE: 1 INCH = 400 FEET



DAM SITE

NW1/4 of NE1/4
SECTION 8

RECEIVED

NOV 10 1994


WATER RIGHT
SALEM, OREGON

SE1/4 of NW1/4
SECTION 8

SW1/4 of NE1/4
SECTION 8

ACREAGE COVERED BY RESERVOIR
NW1/4 of NE1/4: 0.04 ACRES
SW1/4 of NE1/4: 5.20 ACRES
SE1/4 of NW1/4: 2.60 ACRES
TOTAL: 7.84 ACRES

THIS MAP IS PREPARED FOR
THE EXPRESS PURPOSE TO
SHOW WATER APPROPRIATION
AND USE. IT IS NOT
INTENDED TO SHOW OR
LOCATE PROPERTY OWNERSHIP
LINES.

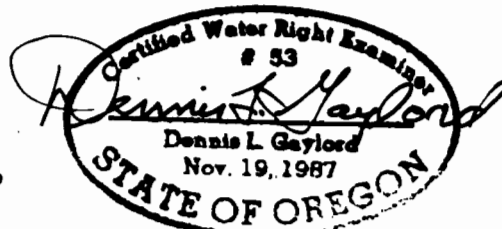

DENNIS L. GAYLORD
CWRE NO. 53
UMATILLA NATIONAL FOREST
2517 S.W. HAILEY AVENUE
PENDLETON, OR. 97801
PHONE: (503) 278-3748

RENEWS 6/30/95