

S 22, T6N, R38E, WM, OREGON

1"=500'

DATE OF SURVEY: 7-30-01

NORTHWEST SECTION CORNER
FOUND 3" BLM BRASSCAP


POINT OF BEGINNING
NORTH 1/4 CORNER
FOUND 3" BLM BRASSCAP

ANGLE POINT

16 15
21 22

15
WEST
199'

POINT OF DIVERSION
LOCATED IN THE
NE1/4 OF THE NW1/4
15 199' WEST AND
470' SOUTH OF THE
POINT OF BEGINNING

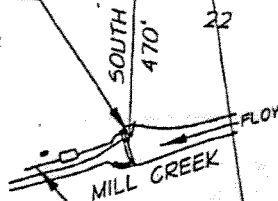

NW1/4-NW1/4
SEC. 22

CONVEYANCE: 3' DIA. PIPE

TAX LOT# 200
NE1/4-NW1/4
SEC. 22

SW1/4-NW1/4
SEC. 22

SE1/4-NW1/4
SEC. 22

WEST 1/4 CORNER
FOUND 3" BLM BRASSCAP

21 22

PLACE OF USE: CITY OF WALLA WALLA
URBAN GROWTH BOUNDARY.

THE PURPOSE OF THIS MAP IS TO
IDENTIFY THE LOCATION OF THE
WATER RIGHT. IT IS NOT INTENDED
TO PROVIDE INFORMATION RELATIVE
TO THE LOCATION OF PROPERTY
OWNERSHIP BOUNDARY LINES.

APPLICATION FILE # 5-84679

RECEIVED

OCT 05 2001

WATER RESOURCES DEPT.
SALEM, OREGON


PERMIT #



CITY OF
WALLA WALLA
MILL CREEK WATER DIVERSION POINT
STATE OF OREGON SURFACE WATER RIGHT
APPLICATION MAP

FIGURE

1

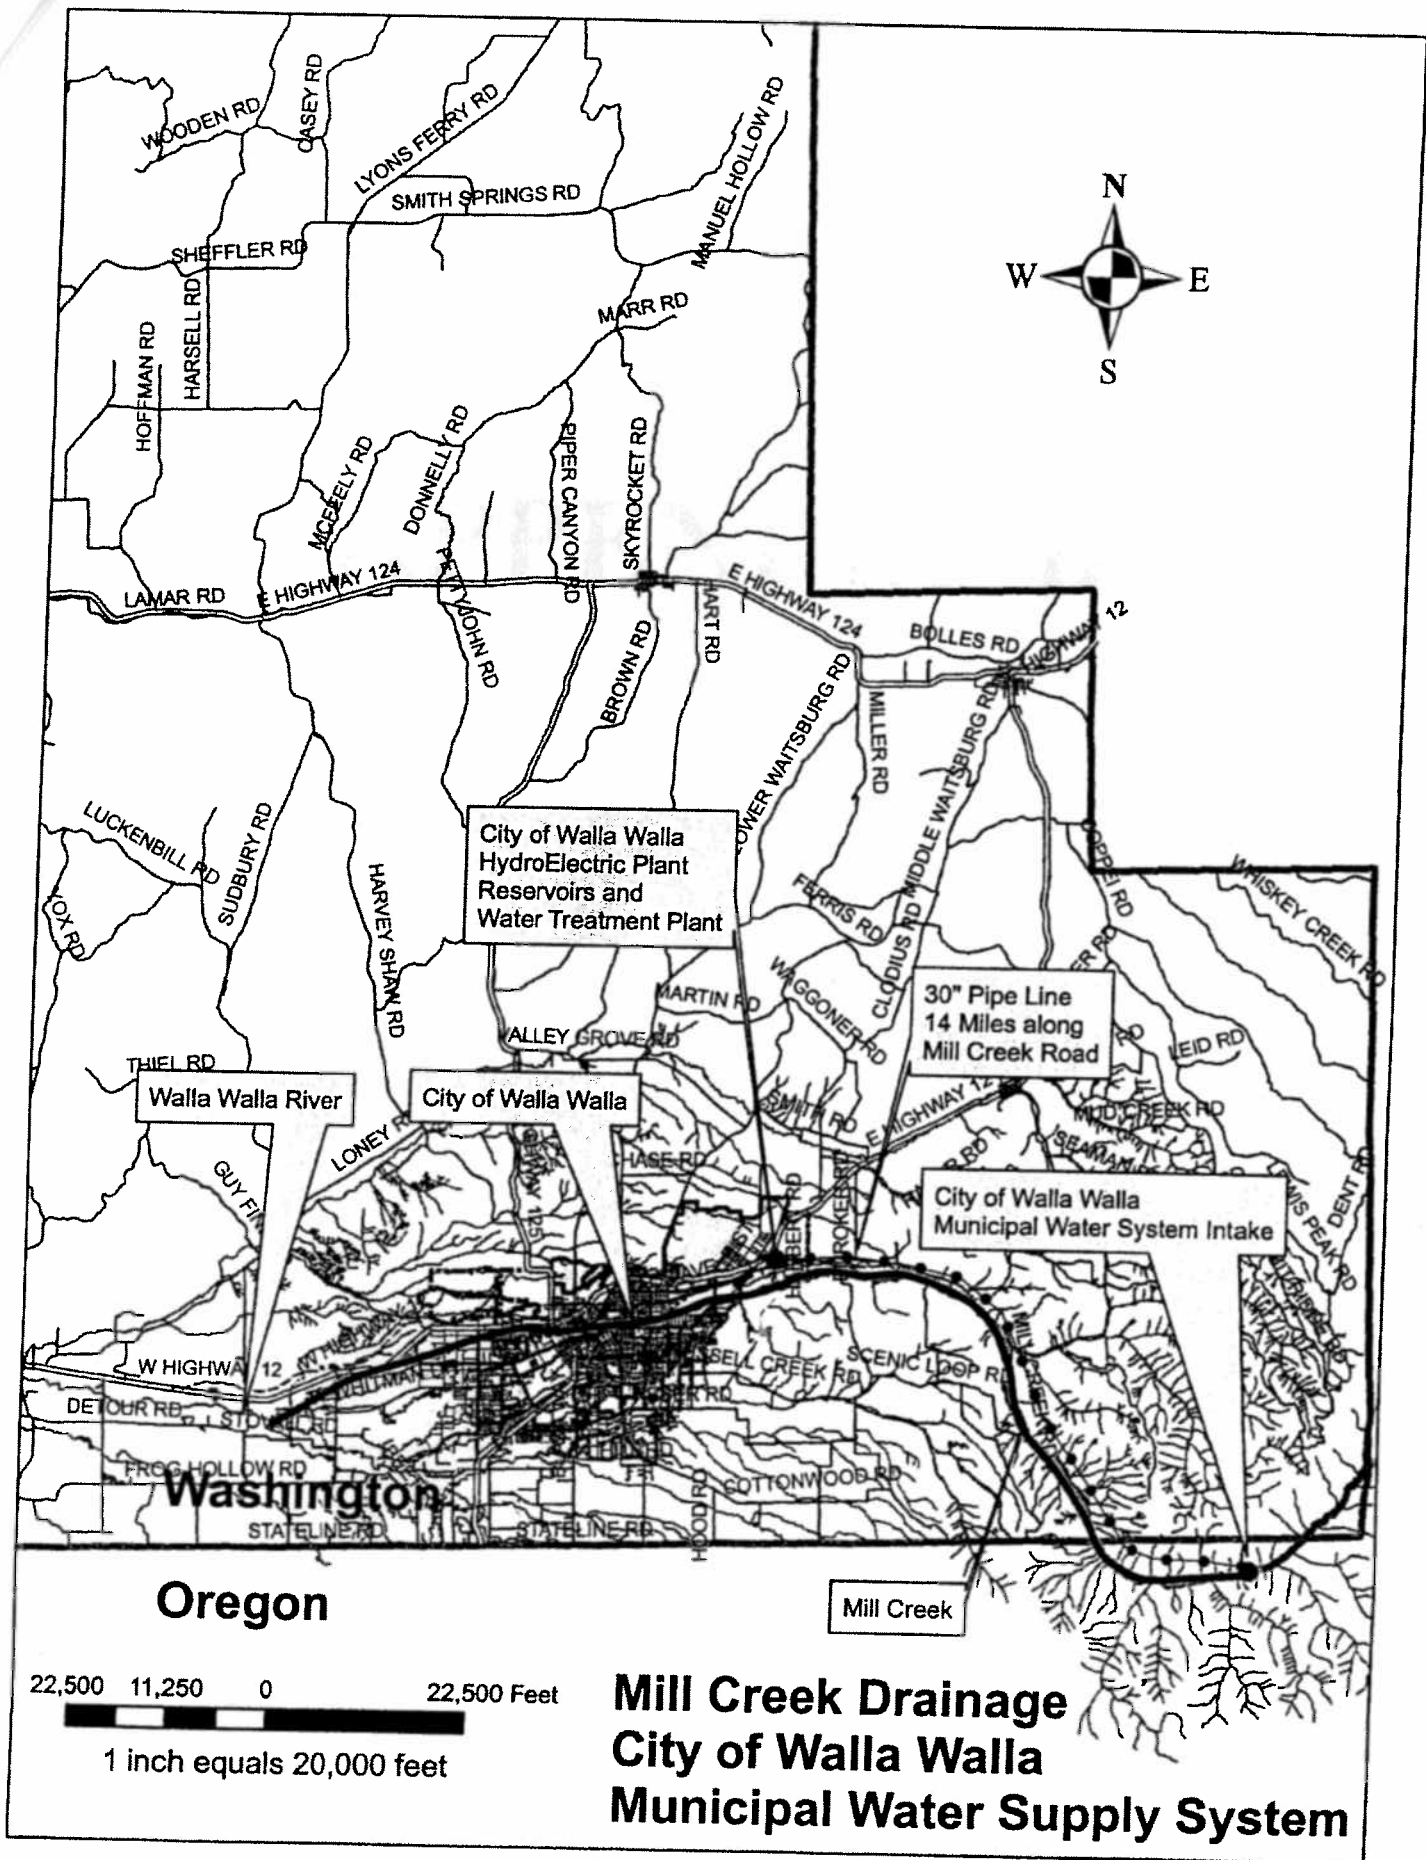

Oregon

22,500 11,250 0 22,500 Feet

1 inch equals 20,000 feet

**Mill Creek Drainage
City of Walla Walla
Municipal Water Supply System**