


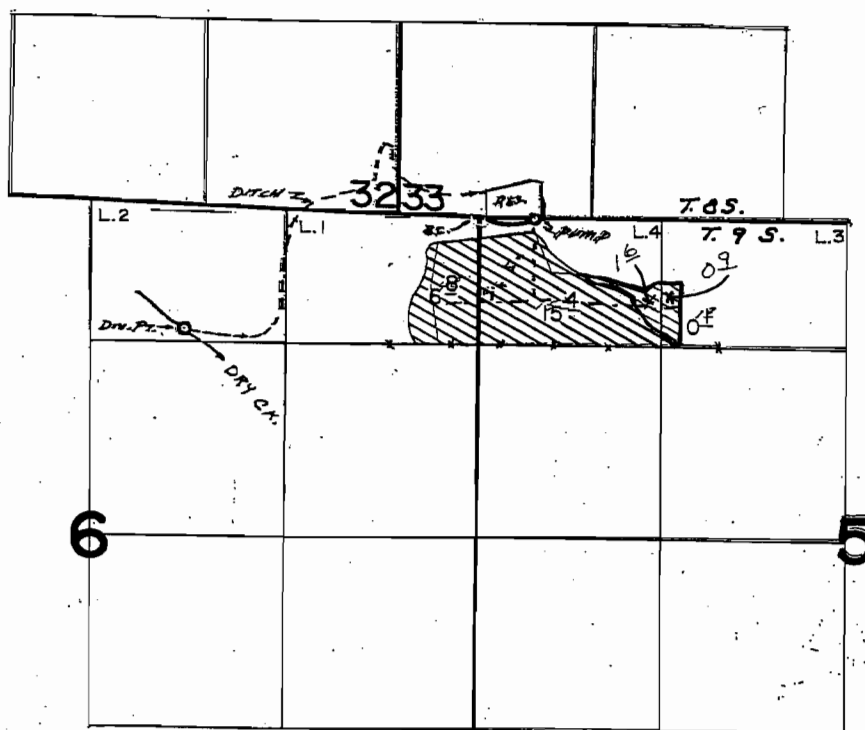

T.8 & 9 S. R.27 E. W.M.



CREEK DIV. PT. - 82.0'S 1450'W 2 Both From SW Cor. Sec. 33
RES. DIV. PT. - 170'N 600'E

FINAL PROOF SURVEY
UNDER

Application No. 54135 Permit No. 40526
IN NAME OF

TOM J. & M. DARLENE DOHERTY

Surveyed Oct. 13, 1977, by S.C. BROWN
Surveyed June 16, 1988, by Z.F. SALEH

3-19-90
41023-179-60R
PTS-1977-L