


T.17 S., R.22 E., W.M.

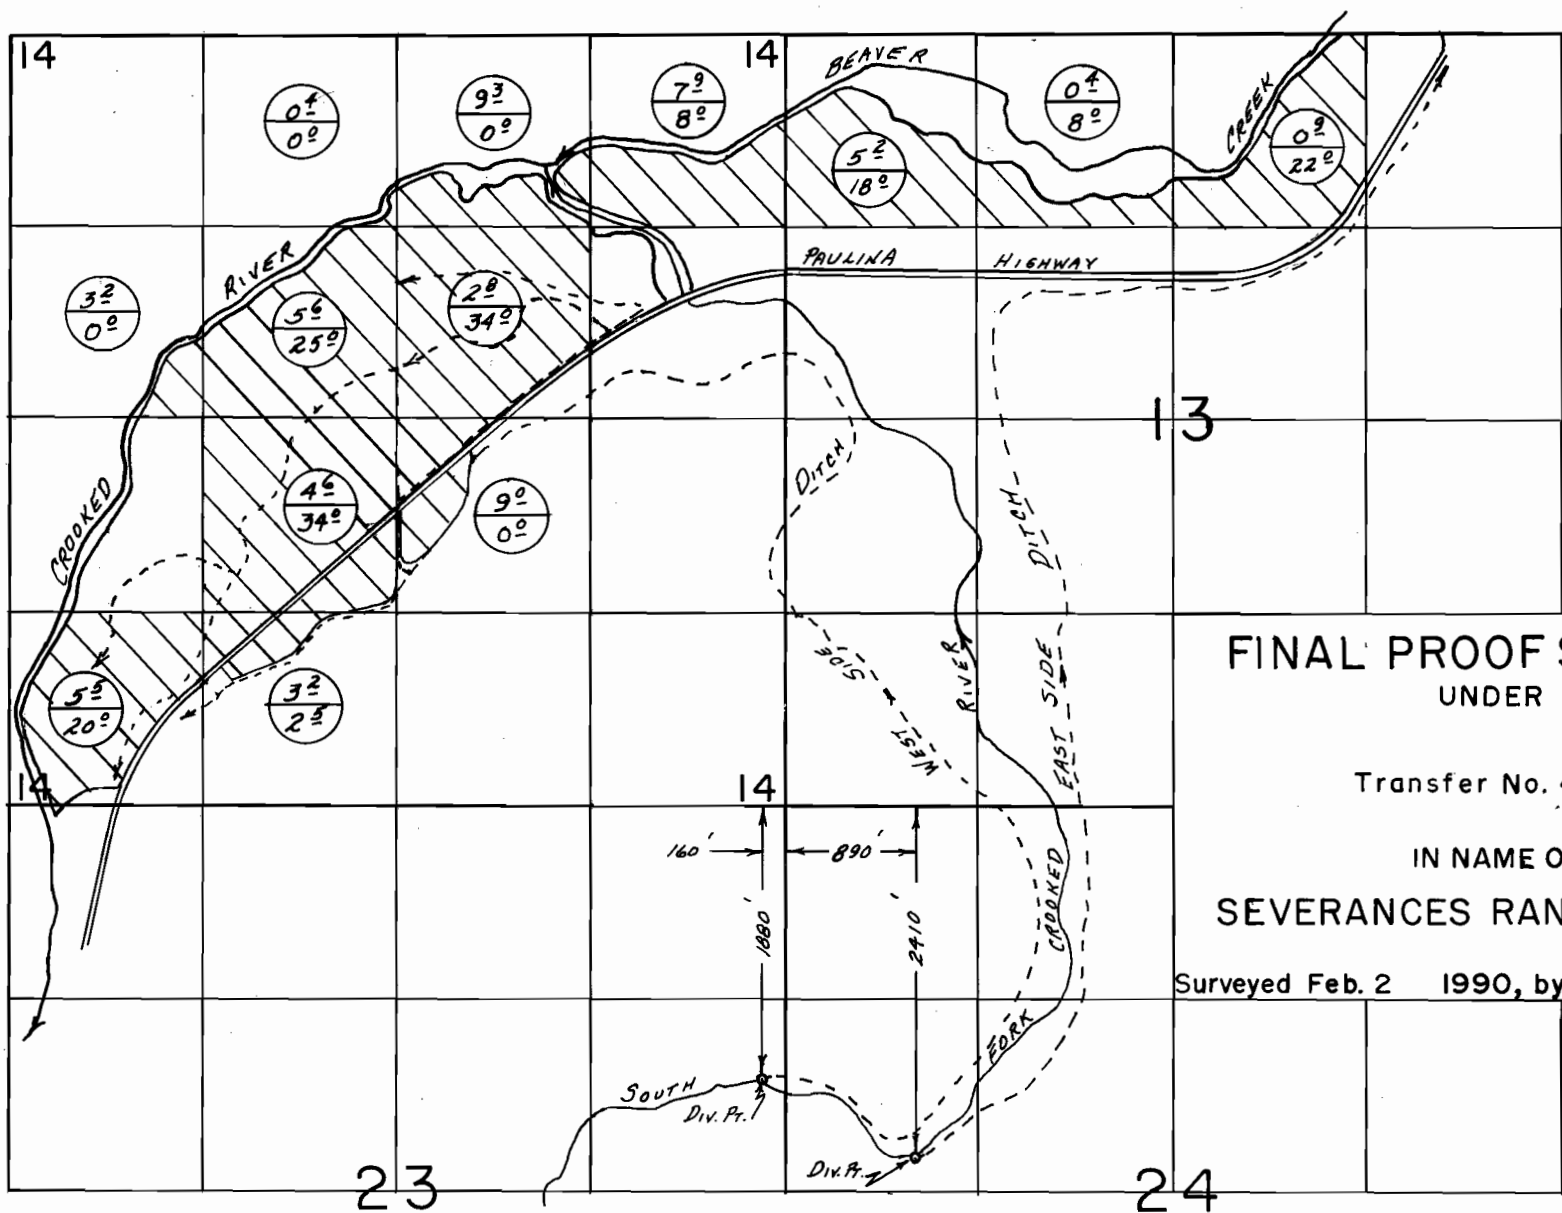

FINAL PROOF SURVEY
UNDER

Transfer No. 4738

IN NAME OF
SEVERANCES RANCH, INC.

Surveyed Feb. 2 1990, by B.W. BISHOP

Tr. 4738
Cert. 545

Scale: 1" = 1320'

1/3/91
41013-280-81D B.W.B.