





# T. 7S., R. 19E., W.M.

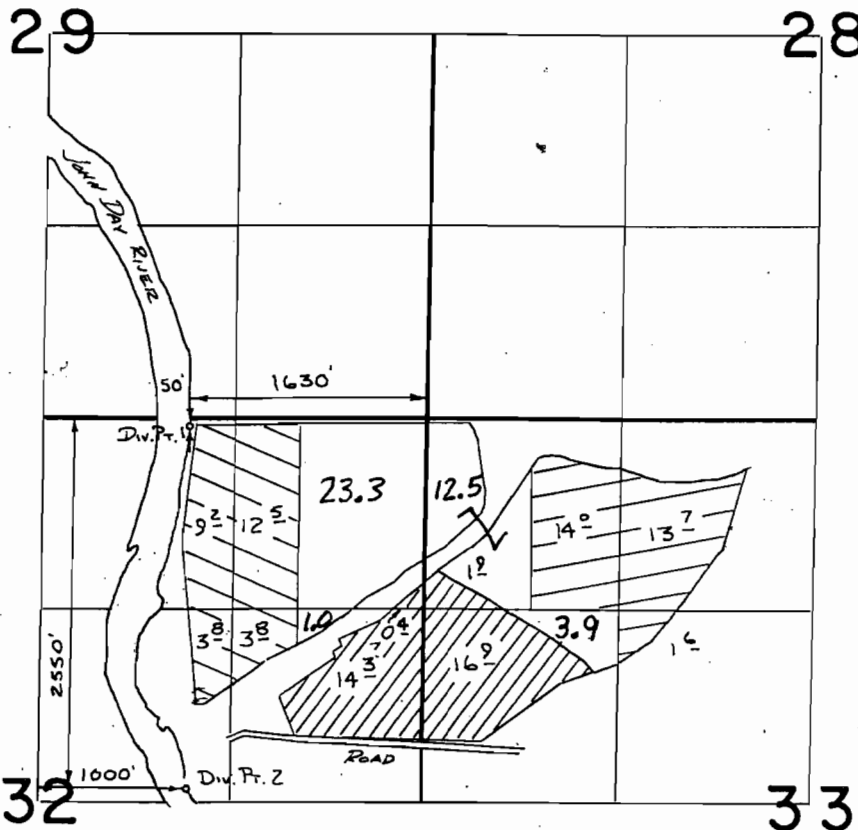

SCALE 1" = 1320

 T-4752    
  T-4751    
  P#44315

## FINAL PROOF SURVEY UNDER

### TRANSFERS 4751, 4752, 5295

Application No. **58592**. Permit No. **44315**.....  
IN NAME OF

**WILLIAM J. BOWERMAN JR.**

Surveyed 5-12..... 1987, by V. L. Church.....