



T.5S., R.2W. & 3W., W.M.

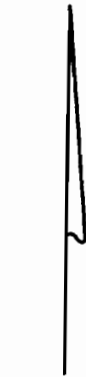

1" = 1320'

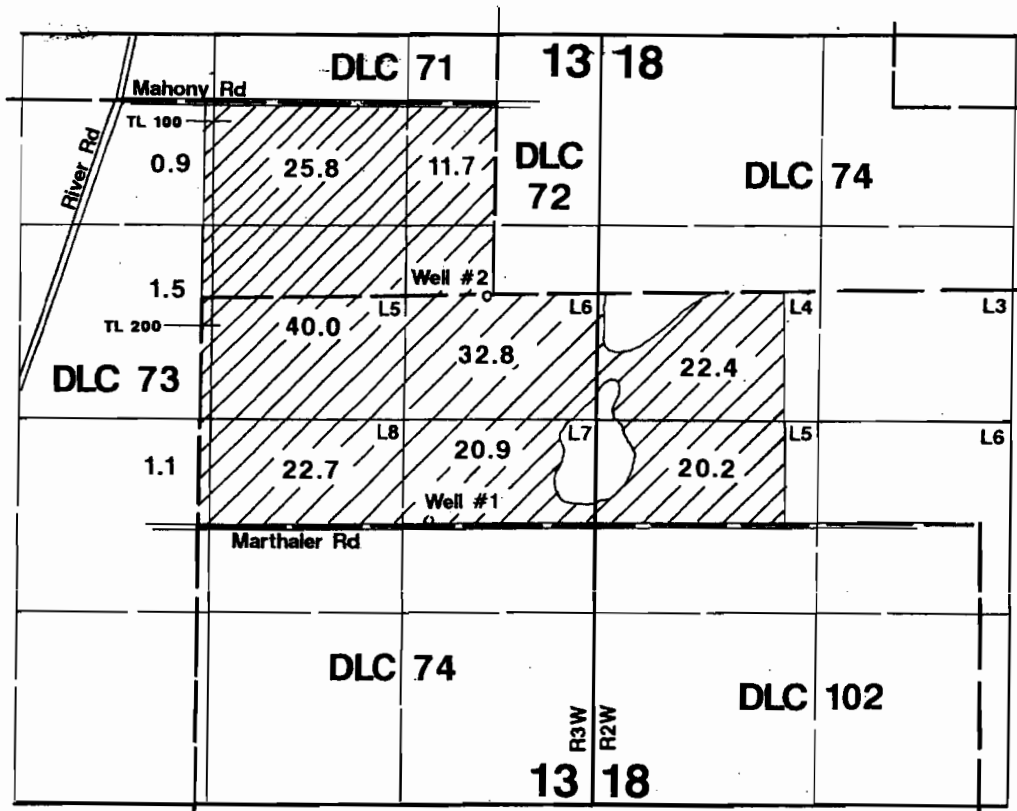

Area Irrigated

Well #1 is located 40' N & 1600' E from the NW corner of DLC 74.
 Well #2 is located 15' S & 25' W from the SW corner of DLC 72.

RECEIVED

AUG 28 2009

**WATER RESOURCES DEPT
 SALEM, OREGON**

Final Proof Survey

Application #: G-13412 Permit #: G-11857

In Name Of

Roselawn Seed, Inc.

Surveyed on August 18, 1998 by JM Schuette

This Map Was Prepared For The Purpose Of Identifying The Location Of A Water Right Only And Is Not Intended To Provide Legal Dimensions Or Location Of Property Ownership Lines.

