


T.14S. R.1W. W.M.

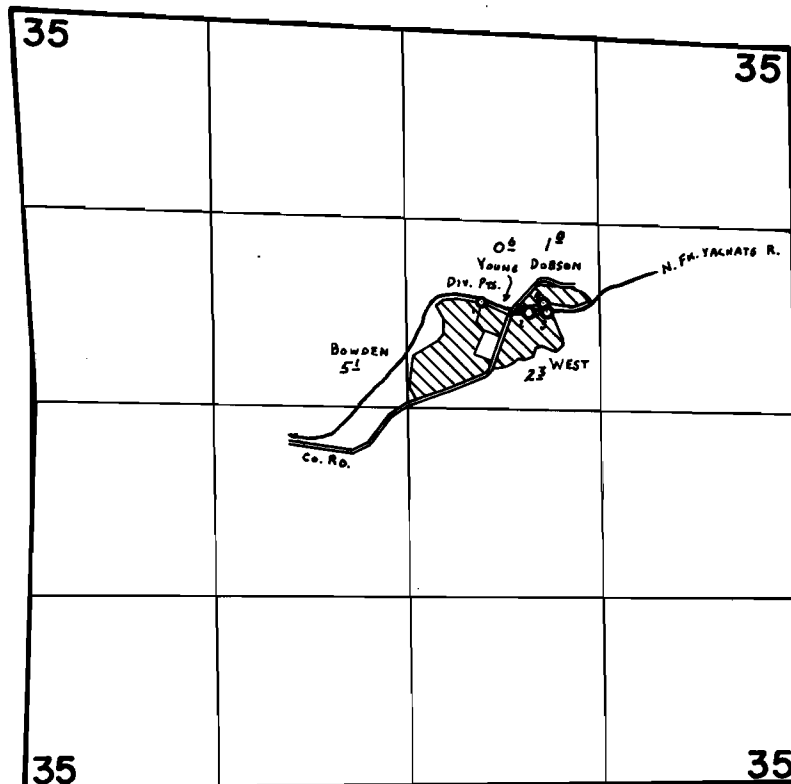

Div. Pts. Loc: #1-730N. 510'E.
 #2-670N. 830'E.
 #3-670N. 960'E.
 #4-730N. 940'E. } ALL FROM C 1/4 COR. SEC. 35.

FINAL PROOF SURVEY UNDER

Application No. 41618..... Permit No. 31034.....
 IN NAME OF
 WILLIAM H WEST, WILLIAM DOBSON
 WALTER H. & BEULAH M. YOUNG, RAYMOND BOWDEN

Surveyed Sept. 19. 1978, by J.S. DONALDSON