


T.3N., R.9W., W.M.
SECTION 7

RECEIVED

NOV 05 1999


WATER RESOURCES DEPT
SALEM, OREGON

LOT 4, LITTLE RACKHEAP CREEK ACRES

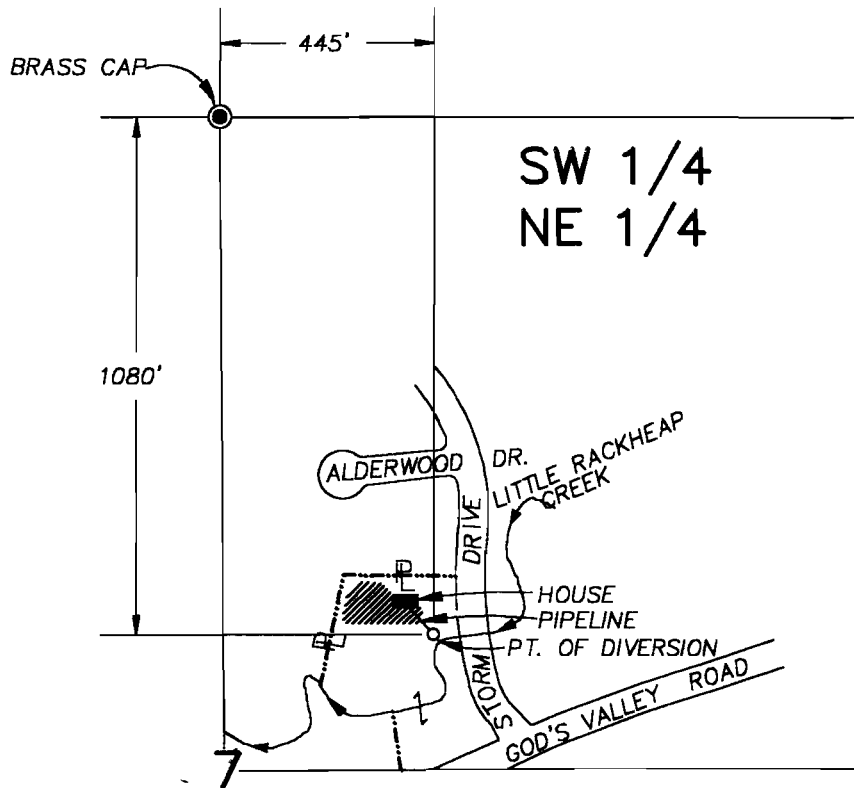

SCALE:
1" = 400'

FINAL PROOF SURVEY
UNDER
APPLICATION NO. 73715, PERMIT NO. 52070
IN THE NAME OF
WILLIAM & BEVERLY BROPHY
SURVEYED OCT. 6, 1999

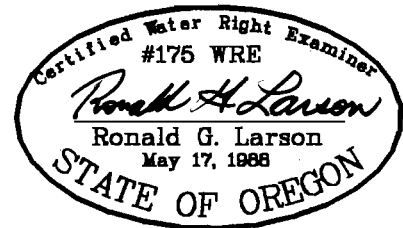

RENEWAL DATE: DECEMBER 31, 2000

FILE: 11034-1903-01-01.FLX

THE PURPOSE OF THIS MAP IS TO IDENTIFY
THE LOCATION OF THE WATER RIGHT. IT IS
NOT INTENDED TO PROVIDE INFORMATION
RELATIVE TO THE LOCATION OF PROPERTY
OWNERSHIP BOUNDARY LINES.

HLB & ASSOCIATES, INC.
SURVEYING • ENGINEERING • PLANNING

4253A HWY 101 N.
GEARHART, OR 97138
(503) 738-3425
FAX: (503) 738-7455