T. 29 S., R. 4 W., W.M.

SCALE: 1" = 400'

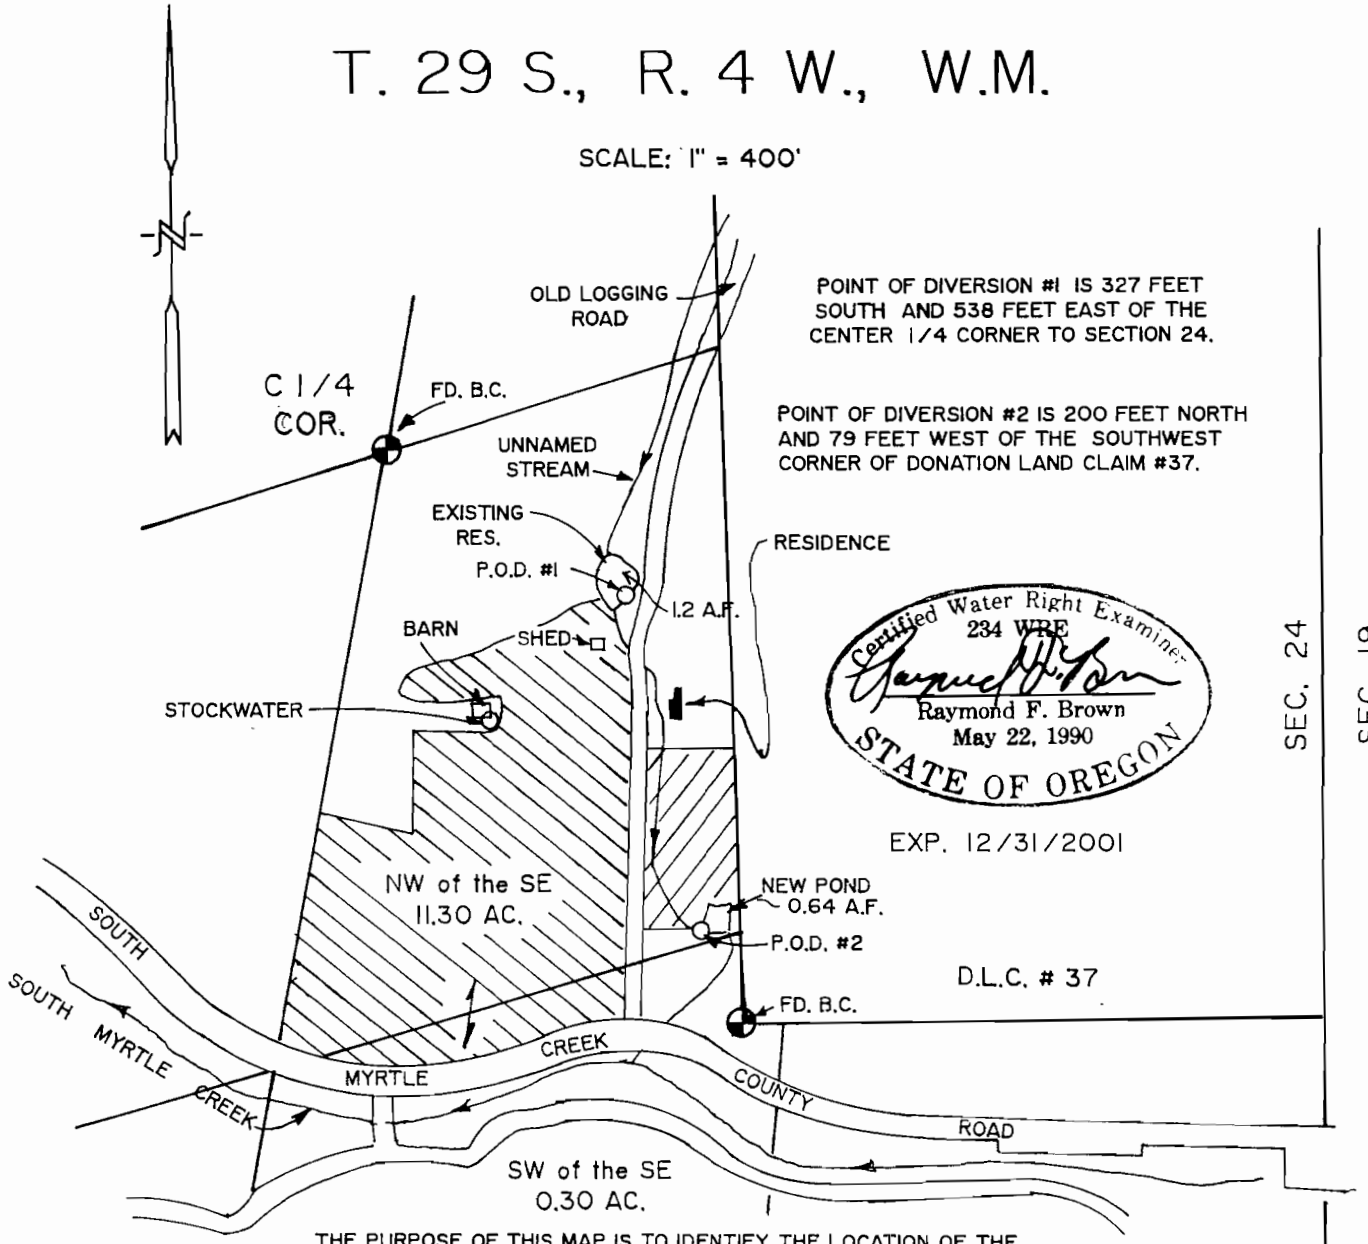

POINT OF DIVERSION #1 IS 327 FEET SOUTH AND 538 FEET EAST OF THE CENTER 1/4 CORNER TO SECTION 24.

POINT OF DIVERSION #2 IS 200 FEET NORTH AND 79 FEET WEST OF THE SOUTHWEST CORNER OF DONATION LAND CLAIM #37.

Certified Water Right Examiner
234 WRE
Raymond F. Brown
May 22, 1990
STATE OF OREGON

EXP. 12/31/2001

THE PURPOSE OF THIS MAP IS TO IDENTIFY THE LOCATION OF THE WATER RIGHT. IT IS NOT INTENDED TO PROVIDE INFORMATION RELATIVE TO THE LOCATION OF PROPERTY OWNERSHIP BOUNDARY LINES.

PRIMARY - SOUTH MYRTLE CREEK, PERMIT # 38958
SUPPL. - STORED WATER FROM PONDS.

FINAL PROOF SURVEY

UNDER

Application No. S-73508 R-73507 Permit No. 52179 R-11774

IN NAME OF

RICHARD A. AND SANDRA L. GRAF

Surveyed: SEPT. 15, 2000 by: R.F. BROWN