


Owner: Lynn Merrill

20 E. Airport Rd #277, Lebanon, OR 97355

RECEIVED

JUN 25 2008

WATER RESOURCES DEPT.
SALEM, OREGON

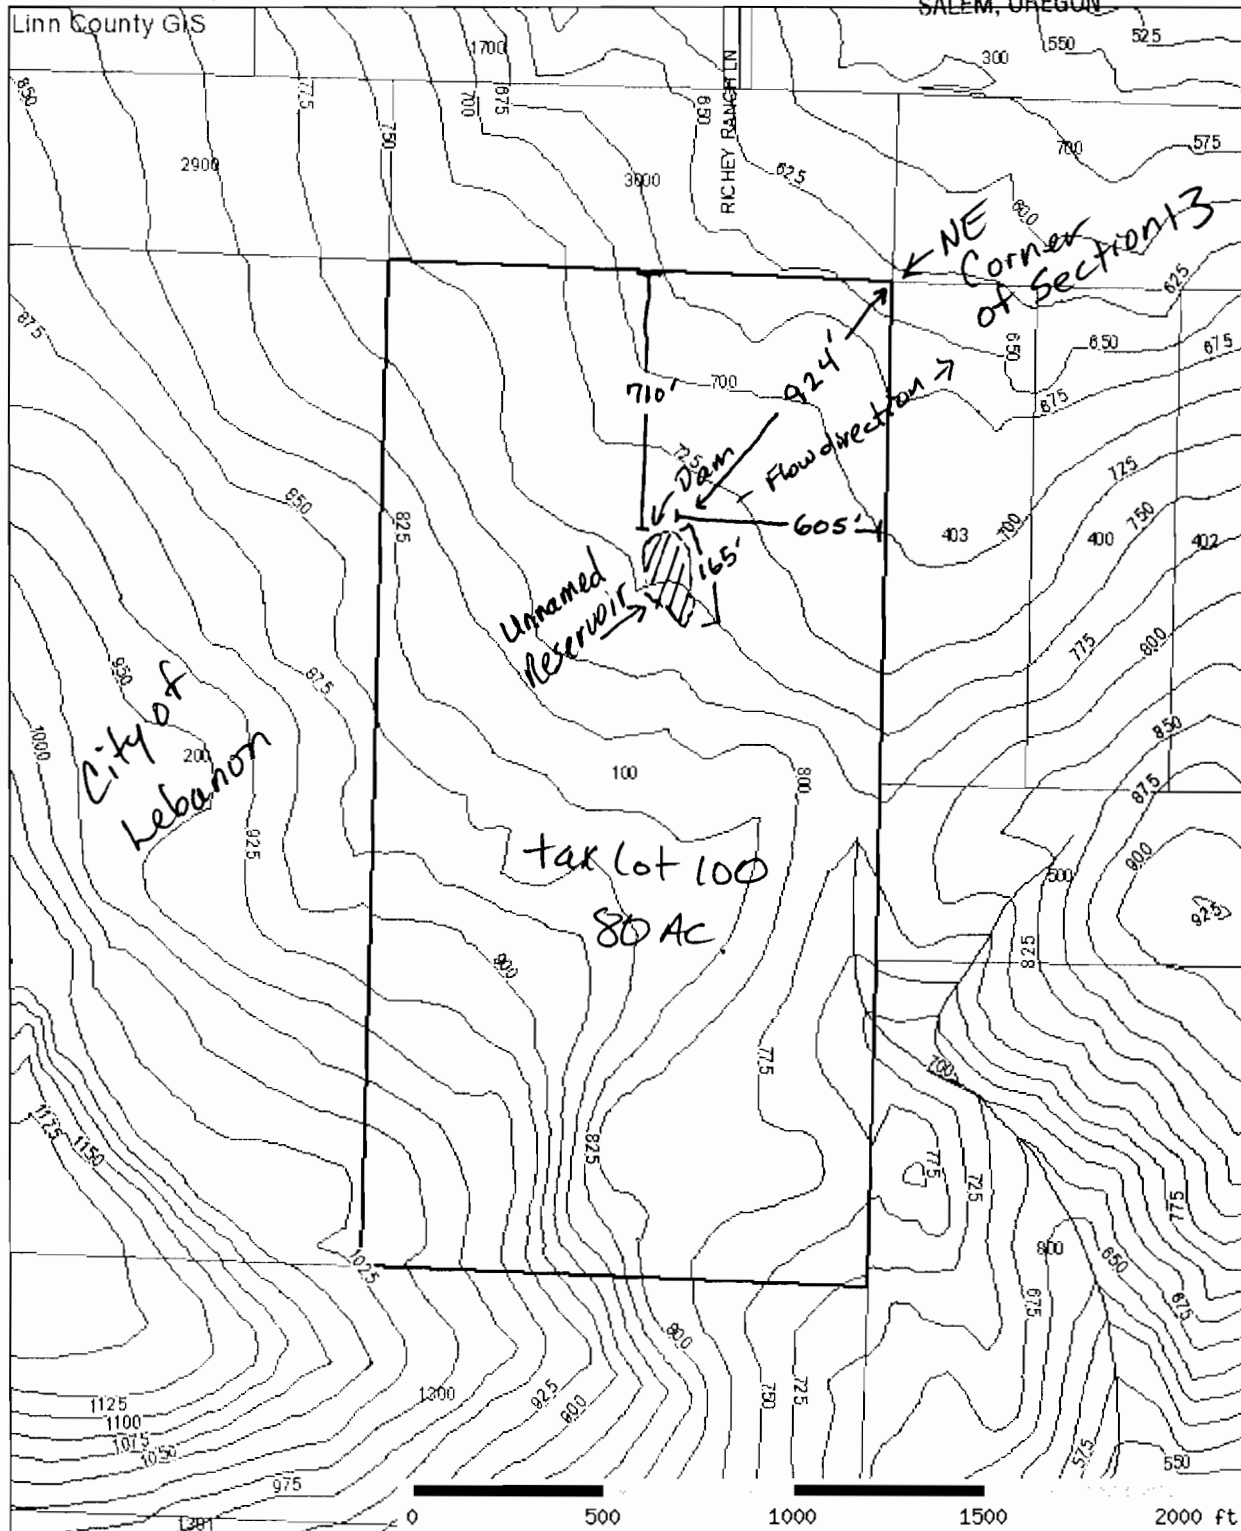

* Reservoir is approximately 120 ft wide, 165 feet long, and 15 ft deep.

* Its dam is located 924 ft from the NE corner of Section 13 along the bearing of $42^{\circ} 24' 13''$ SW.

* Reservoir is primarily excavated rather dammed and holds 6.75 acre-feet of water.

<http://www.co.linn.or.us/webmap/ELLAMaps1.0/bin/html/print/portrait.htm>

6/20/2008

APP
NO
R87208