


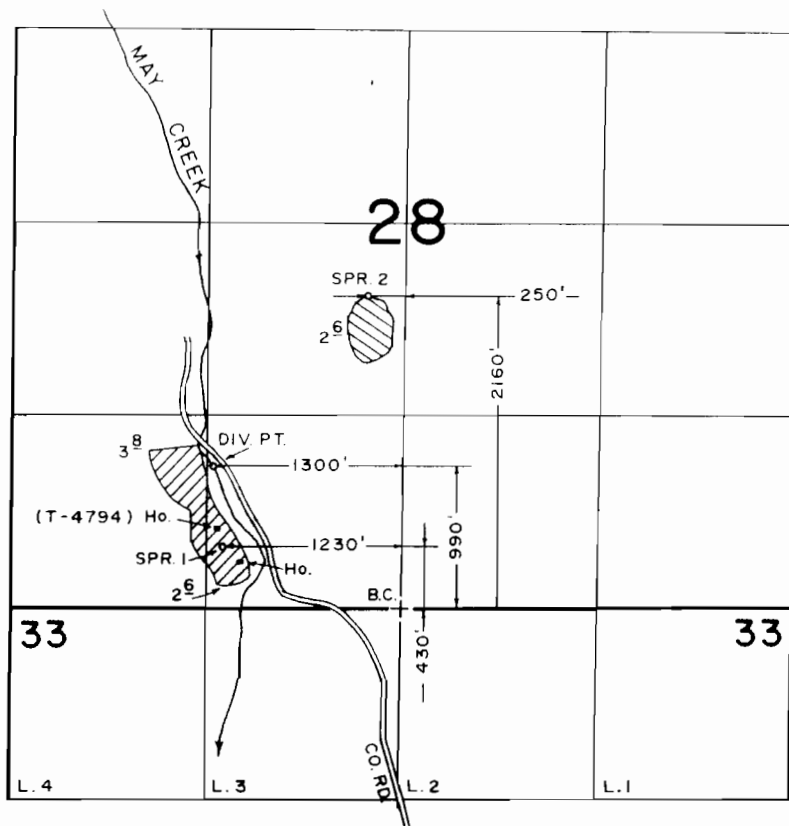

T. 29 S., R. 3 W., W.M.

*1 map for
61838 &
T-4794*



SCALE: 1" = 1320'

FINAL PROOF SURVEY UNDER

 SPRING 2
 MAY CREEK

TRANSFER NO. 4794

Application No. 61838... Permit No. 46261...
IN NAME OF

RALPH L. & AGNES K. DUNCAN

Surveyed APRIL 3, 1990, by B.S. JAMES...