


# CLAIM OF BENEFICIAL USE T-10395

In The Name Of: CYNTHIA EDWARDS

Section 5, Township 35 South, Range 3 West, W.M.

Jackson County, Oregon

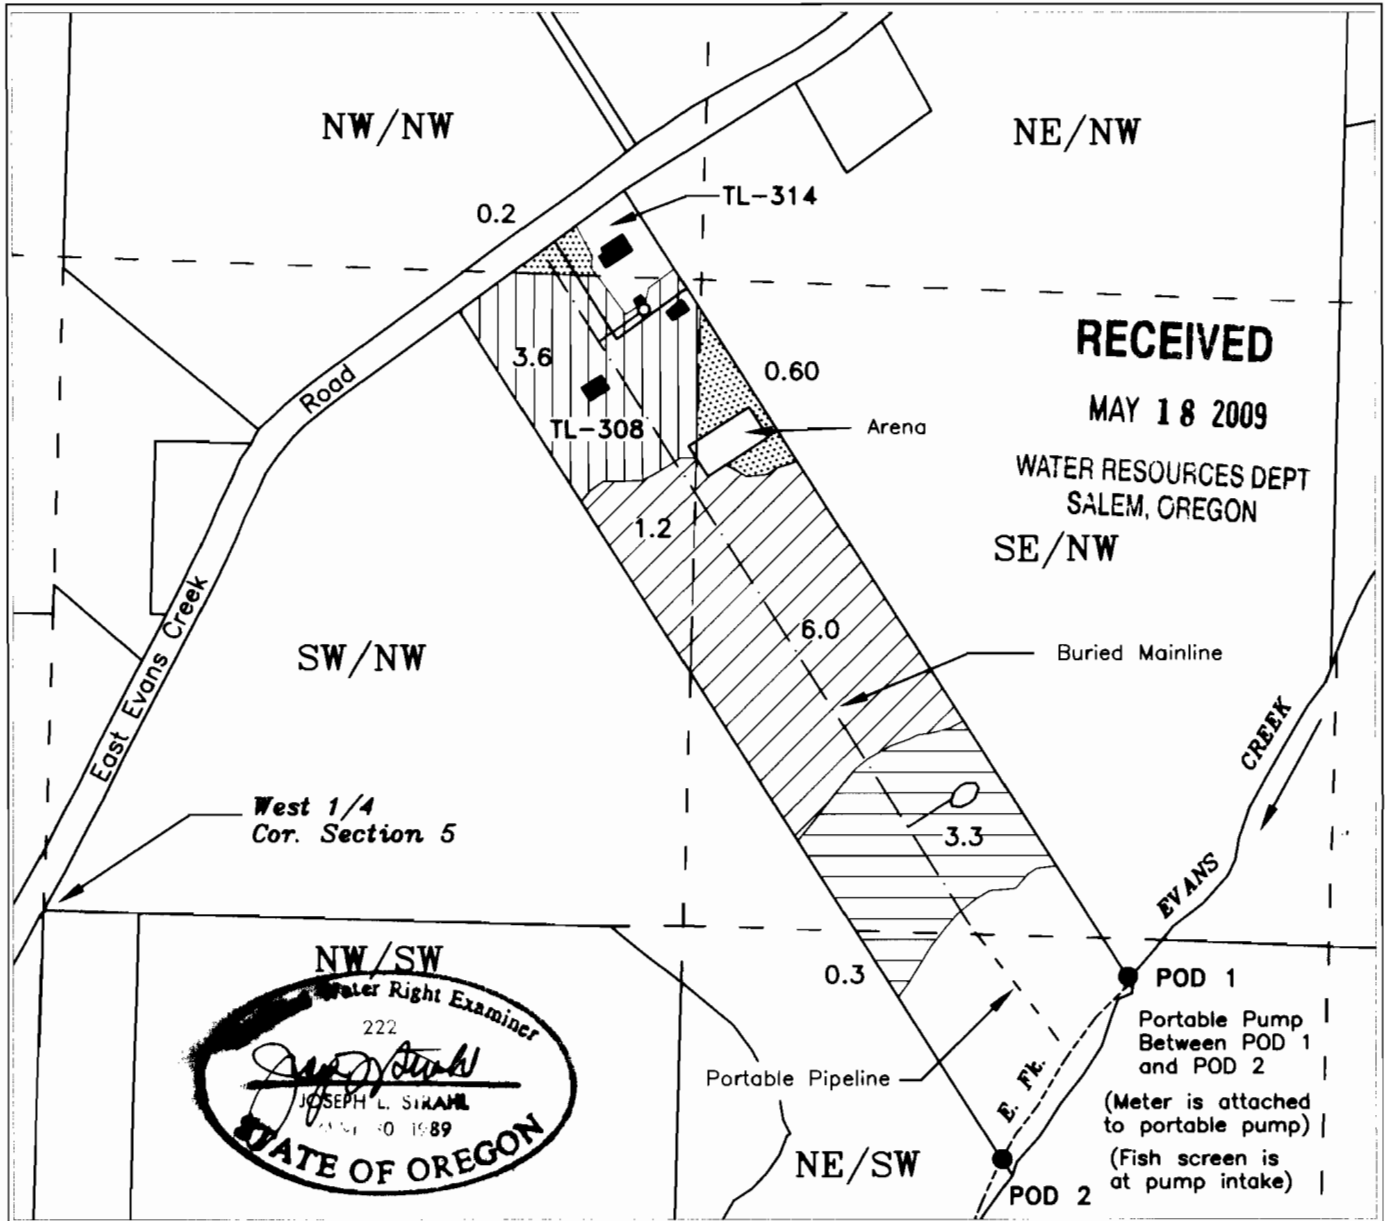

POINT OF DIVERSION - NE/SW, , Between POD-1, 85 feet south & 2260 feet east and POD-2, 480 feet south & 2015 feet east, both from the west 1/4 corner section 5, T.35S, R3W, W.M.



Certificate 51335, Mays Cr.  
0.80 acres, 1901



Certificate 50143, Mays Cr. & Reservoir  
3.6 acres, 3/6/1947




Certificate 43986 Evans Cr. (E.Fk.)  
3.6 acres, 5/27/1917



Certificate 43985, Evans Cr. (E.Fk.)  
7.2 acres, 12/1/1923

Certificate 24152 Mays Cr.  
7.2 acres, Supplemental 12/4/1956

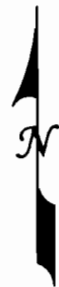

Scale  
1 inch = 400 feet



5/12/2009 n.e.d.

This map is not intended to provide legal dimensions or locations of property ownership lines

Base Map: Jackson County GIS data with 2005 FSA aerial photo overlay