


TOWNSHIP 15 SOUTH, RANGE 10 EAST, W.M.

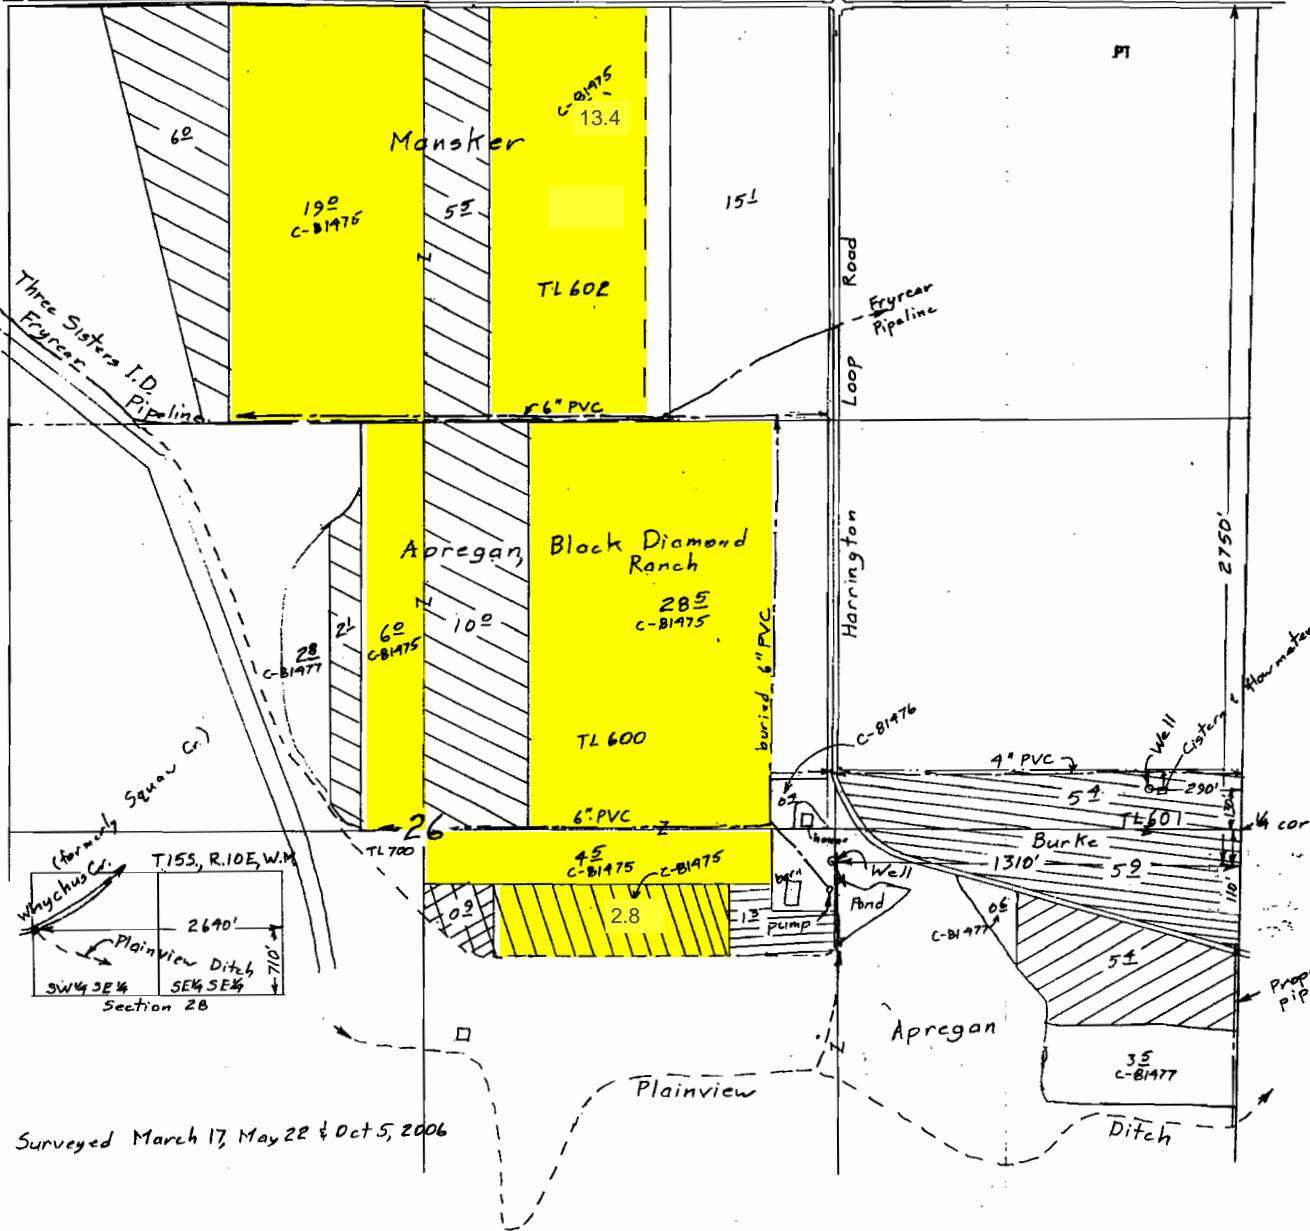

Claim of Beneficial Use Map
for
Craig Apregan, Mike Mansker
and Doug & Barbara Burke



RECEIVED
MAR 06 2007
WATER RESOURCES DEPT
SALEM, OREGON

Scale 1" = 400'

T- 9571

- Trsf Order
- ⊖ #10 (Burke) 11.2 acres supp to 1904
 - ⊖ #11 (Mansker) 11.5 acres supp to 1895
(Apregan) 10.2 acres supp to 1885
2.1 acres supp to 1895
 - ⊖ #14 (Apregan) 1.3 acres primary
 - ⊖ #17 (Apregan) 6.2 acres supp to 1904
 - ⊖ #19 (Apregan) 4.7 acres 1904 primary

COMMP # 0260

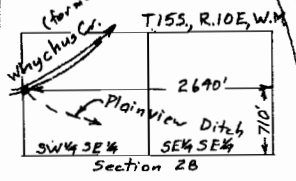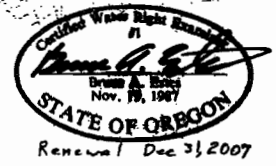

Surveyed March 17, May 22 & Oct 5, 2006

This map is for the purpose of locating a water right only and has no intent to provide legal dimensions or the location of property lines.

ESTES SURVEYS, LLC
PO Box 17518 60382 Arnold Rd
Salem, OR 97306-7518 Bend, OR 97702
(503) 886-7383 (541) 382-7391