


RECEIVED

AUG 14 1997

WATER RESOURCES DEPT.  
SALEM, OREGON

# T.6S., R.4W., W.M.

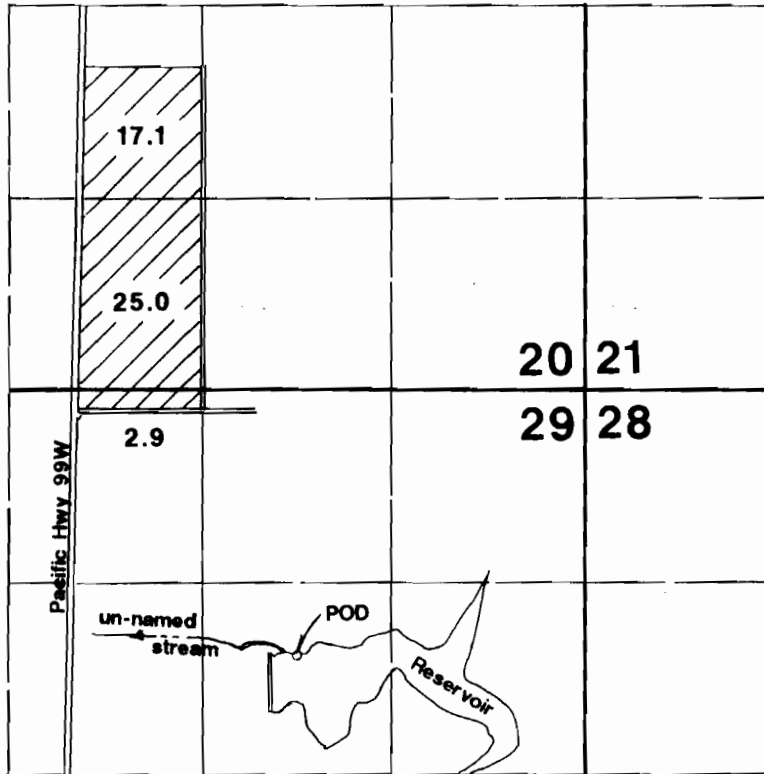

POD located 1860'S & 2000'W from NE corner Section 29.

## Final Proof Survey

Application #: 73098      Permit #: 51539

In Name Of

# Eugene E. Rohde

Surveyed on August 1, 1997 by JM Schuette

THIS MAP WAS PREPARED FOR THE PURPOSE OF IDENTIFYING THE LOCATION OF A WATER RIGHT ONLY AND IS NOT INTENDED TO PROVIDE LEGAL DIMENSIONS OR LOCATION OF PROPERTY OWNERSHIP LINES.

