


Claim of Beneficial Use

T3S R36E Section 25 WM

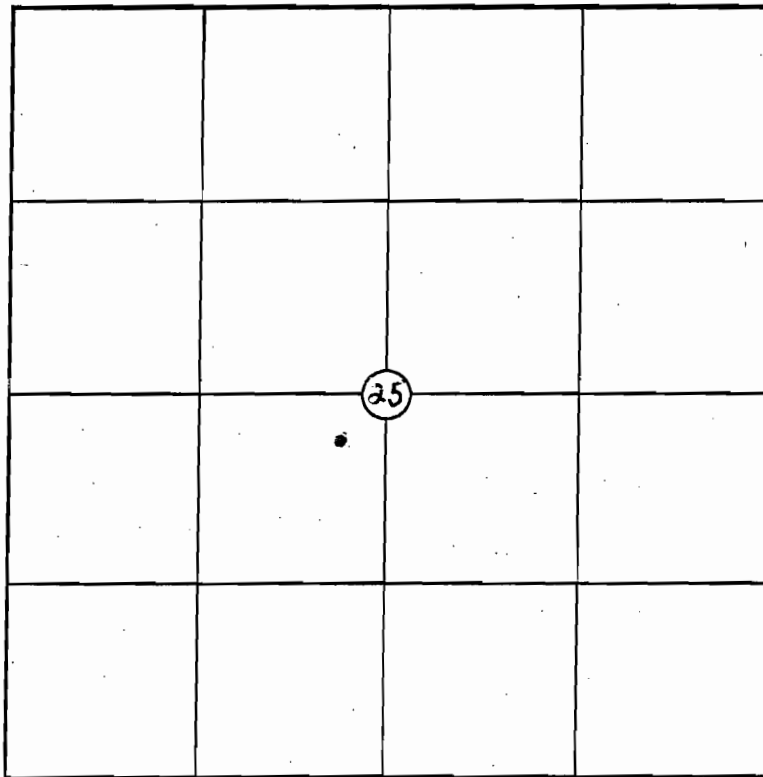

1 inch = 1320 feet

0 0.125 0.25 0.5
Miles

~~Well~~ Pond

Location: 2050 Feet (N) (S)
and 2050 Feet (E) (W) of SW Corner

Application Number R-87259

Permit Number R-14783

RECEIVED

MAR 25 2010

WATER RESOURCES DEPT
SALEM, OREGON

IN NAME OF:

Carl W. Hogg, Jr.

Date: 3/24/2010

Staff Initials: _____



