


T. 17 S.,
R. 19 E., W.M.

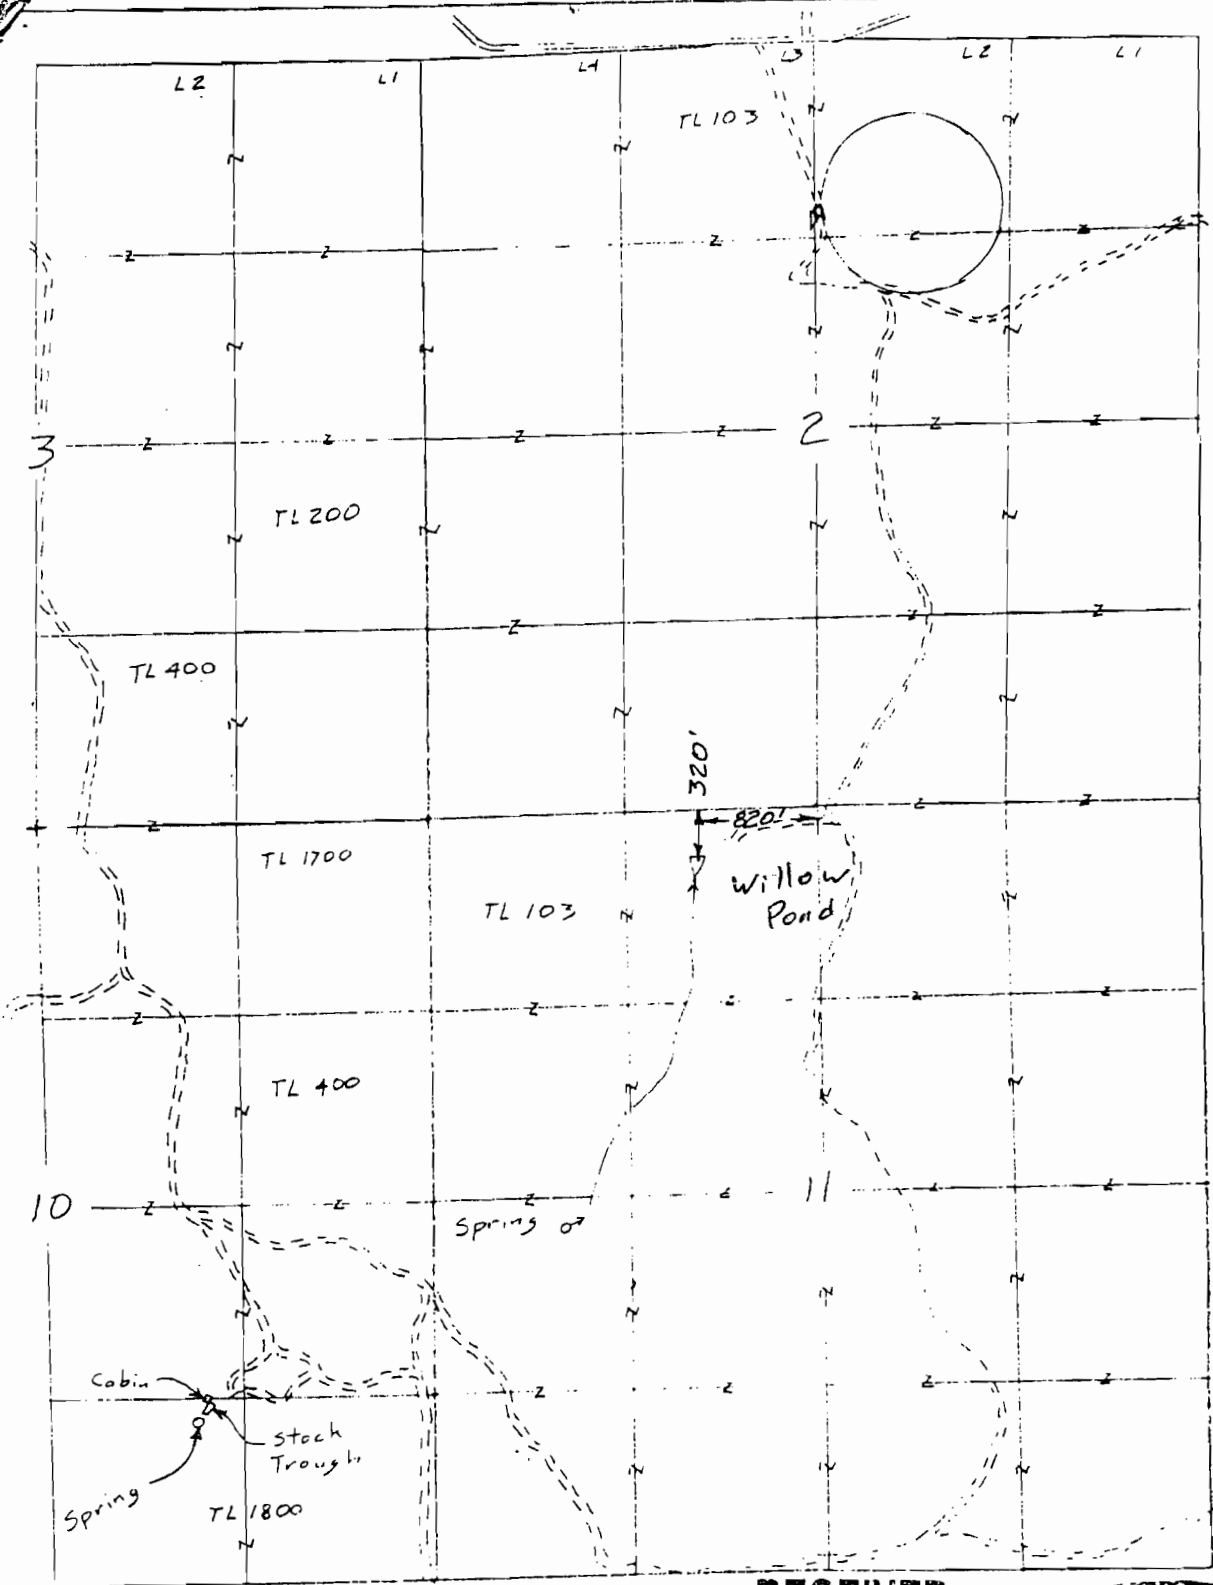

Scale 1" = 1320'
(4" = 1 mile)




Application Map
for
RANCE KASTOR

RECEIVED

FEB 25 2009

WATER RESOURCES DEPT
SALEM, OREGON

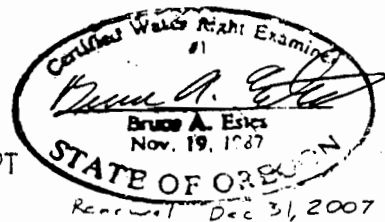

R-86750
R-14488

This map is for the purpose of
locating a water right only
and has no intent to provide
legal dimensions or the location
of property lines.

ESTES SURVEYS, LLC
PO Box 17519, 60382 Arnold Rd
Salem, OR 97305-7519 Bend, OR 97702
(503) 585-7593 (641) 382-7391