


17061800

FOR ASSESSMENT AND
TAXATION ONLY

SECTION 18 T.17S. R.6W. W.M.
Lane County
1" = 400'

GIS DATA
8/22/2007 4:19:54 PM : kcartm

CANCELLED:
400

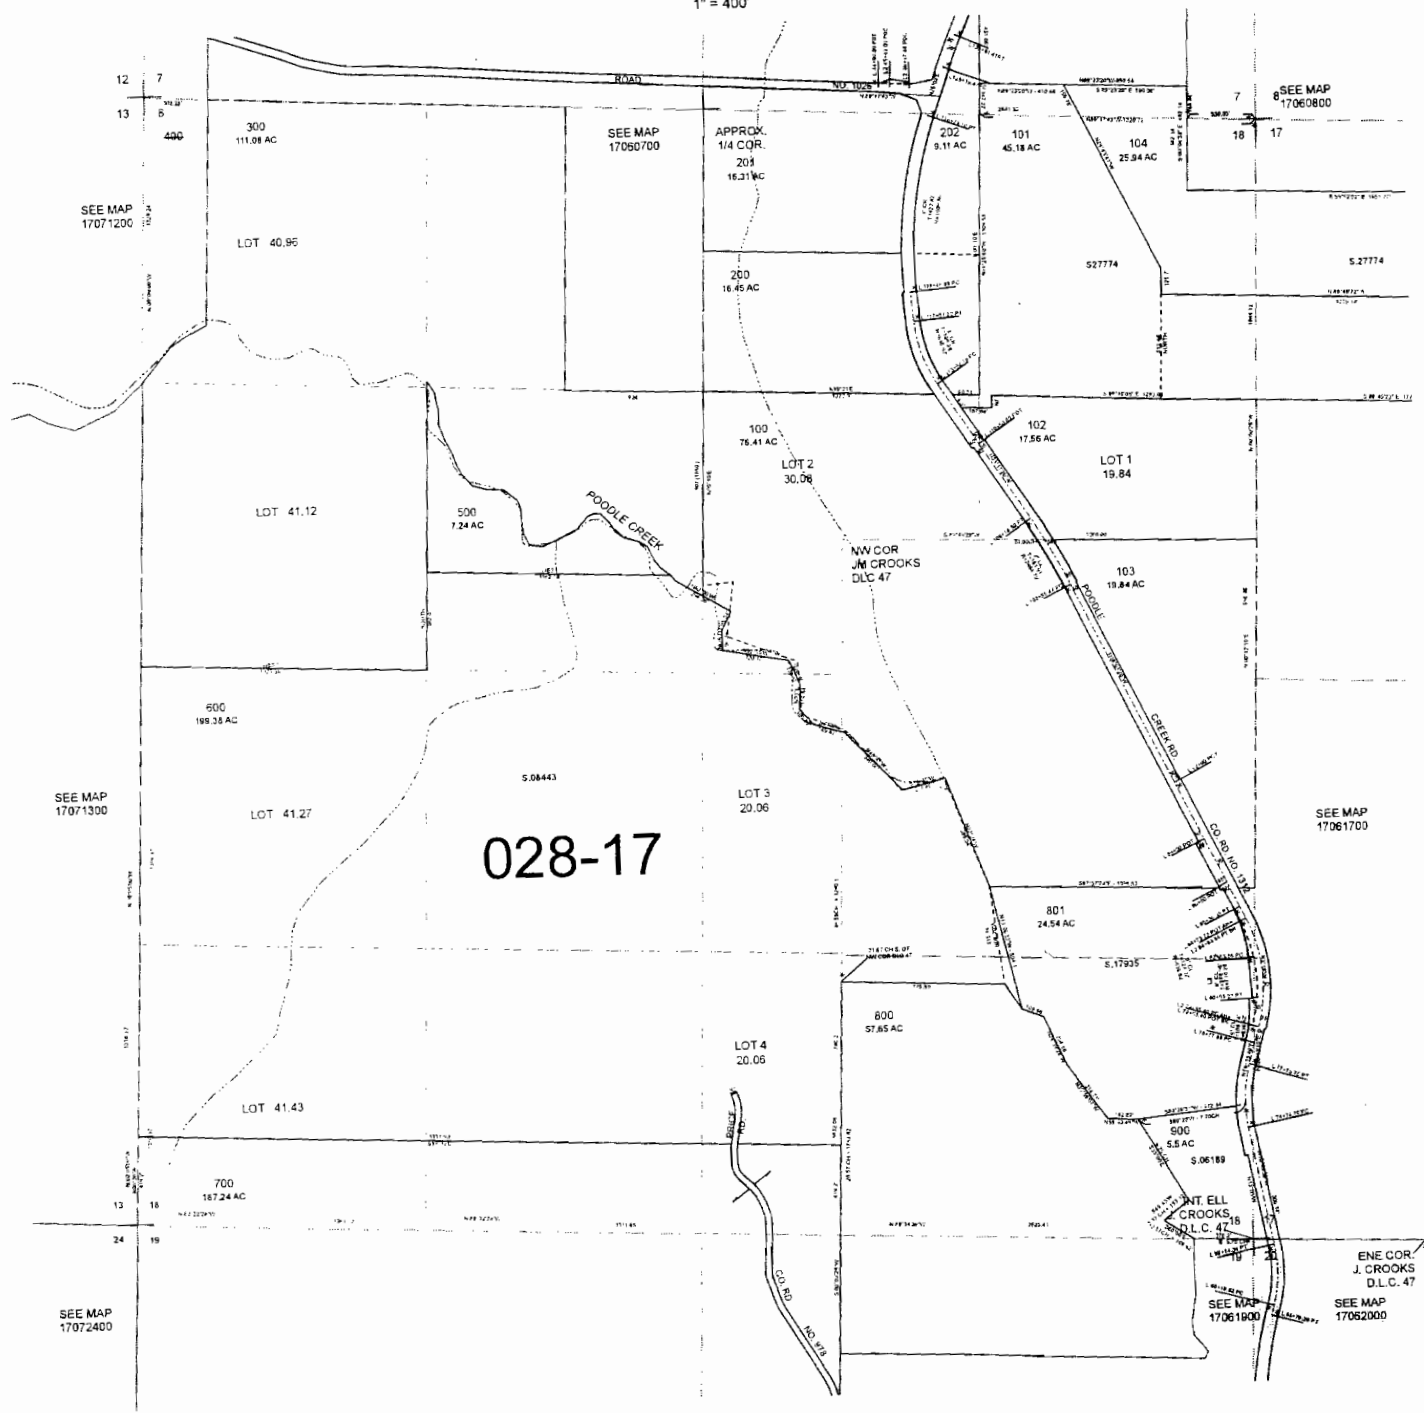



1" = 400'

Oak Pond LLC
Jack Gray
89762 Peoria Cr. Rd.
Noti, OR 97461

RECEIVED

AUG 06 2008

WATER RESOURCES DEPT
SALEM, OREGON

100

102

Lot 2 30.08

Lot 1 1984

NW Cor.
JM Crooks
DLC No. 47

NE Cor.
JM Crooks
DLC No. 47

103

RECEIVED

JAN 06 2009

WATER RESOURCES DEPT
SALEM, OREGON

-17

Center
of
Section
18

Lot 3 20.06

801

Excavation
Area location:
690' W and
520' S of the SE
corner of NESE
quarter of sect. 18

Existing
Creek
← Proposed
excavation
Dam

31.67± S. of
N.W. Cor. DLC #47

800

Lot 4 20.06

- Tax Lot #801
- Range 6W
- Township 17S
- Section 18
- SE 1/4

OR 8727 700 Permit No. RTH 1004