

T. 17 S.,  
R. 19 E., W.M.



Scale 1" = 1320'  
(4" = 1 mile)


**RECEIVED**

FEB 25 2009


WATER RESOURCES DEPT  
SALEM, OREGON

R-86746

R-14484

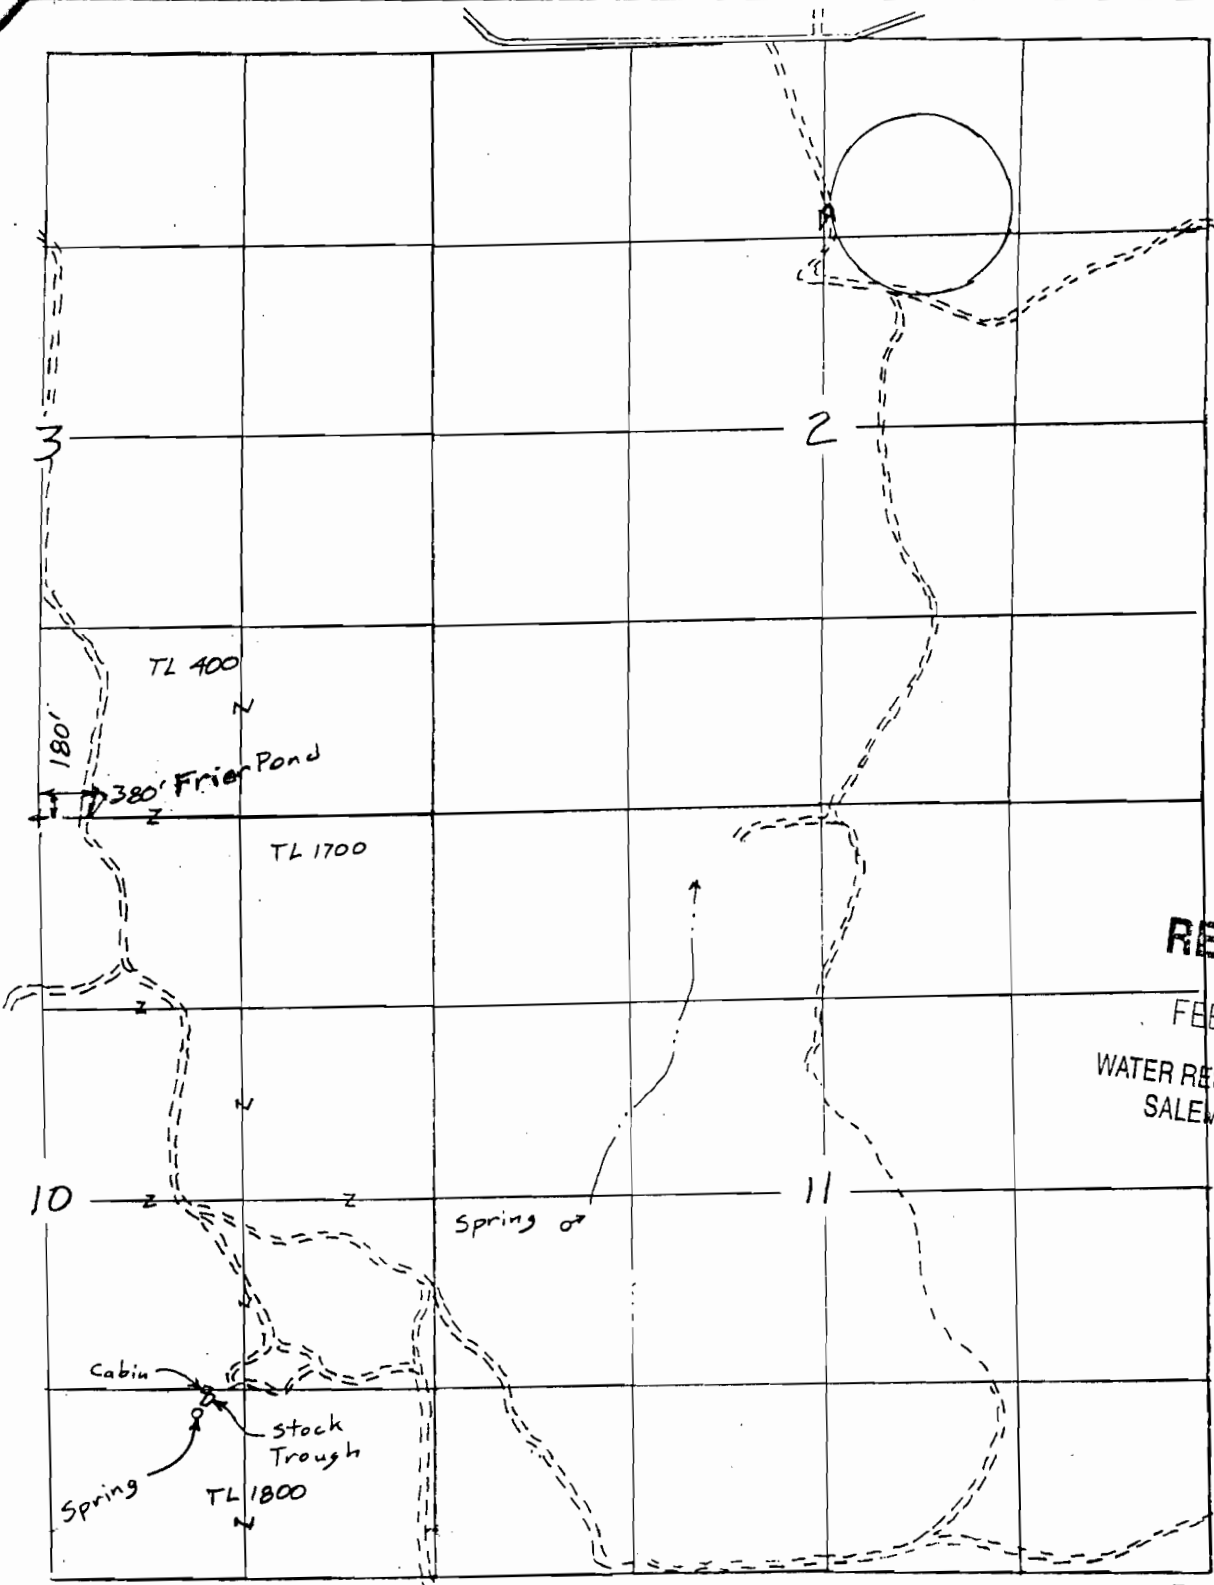

### Claim of Beneficial Use Map for Rance Kastor

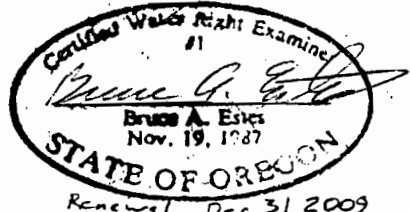

This map is for the purpose of locating a water right only and has no intent to provide legal dimensions or the location of property lines.

**ESTES SURVEYS, LLC**  
PO Box 17519      60382 Arnold Rd  
Salem, OR 97305-7519      Bend, OR 97702  
(503) 585-7593      (641) 382-7391