


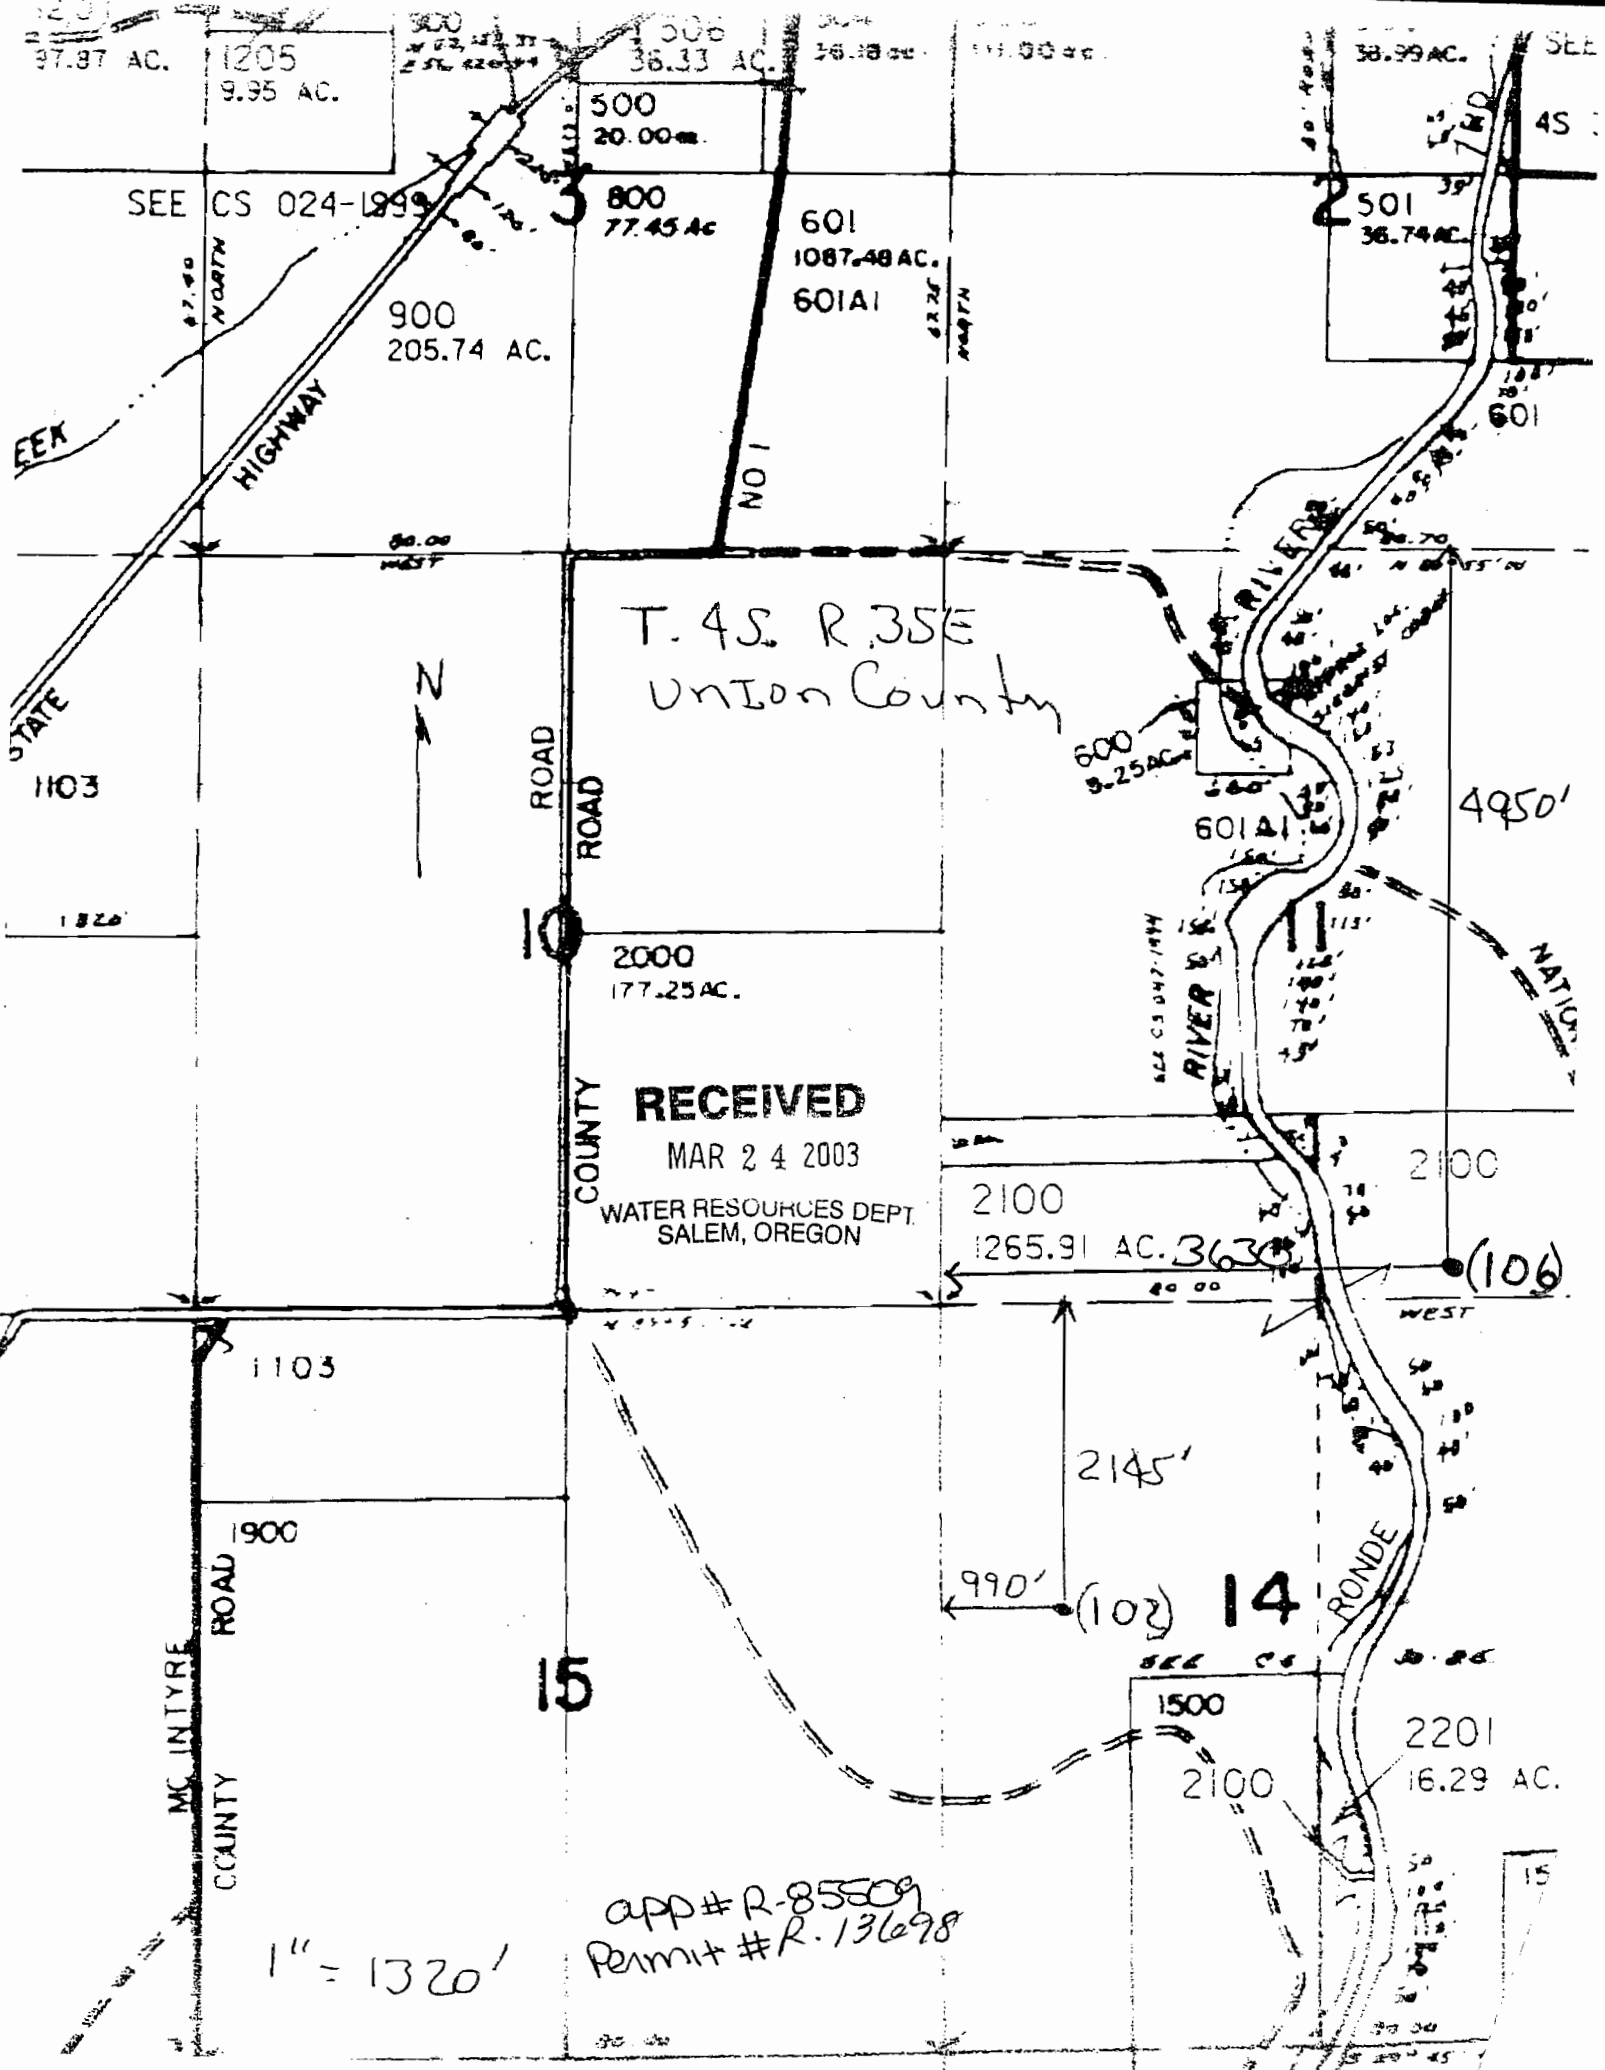

RECEIVED

MAR 24 2003

WATER RESOURCES DEPT.
SALEM, OREGON

T. 4S. R. 35E
Union County

app# R-85509
Permit # R.13698

1" = 1320'

