


CLAIM OF BENEFICIAL USE
 FOR JOHN M. WAITE AND KATHLEEN WAITE
 T26S, R2W, SECTION 16 W.M.
 PERMIT NO S-54524
 FISH SCREEN IS LOCATED AT THE POD
 METER IS LOCATED IN THE PUMP HOUSE
 SCALE: 1" = 400'
 DOMESTIC USE

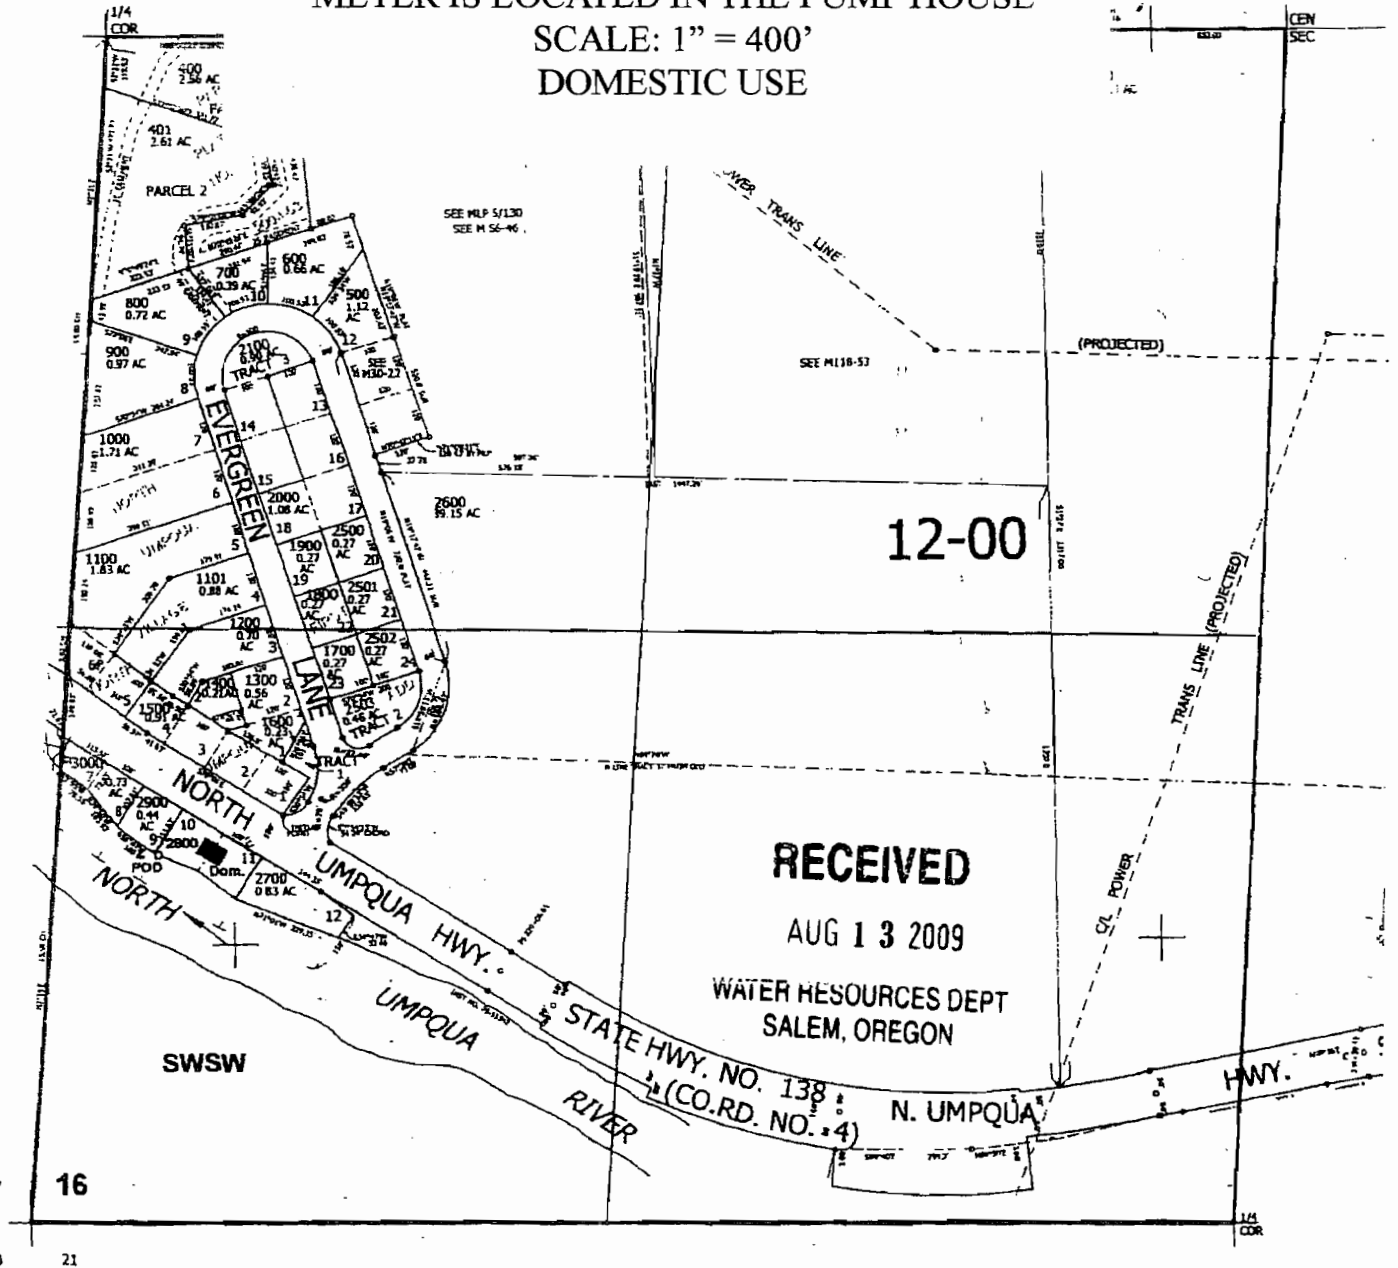

POD is located 800 ft. N. and 275 ft. E. from the SW corner of Sec. 16

THE PURPOSE OF THIS MAP IS TO IDENTIFY THE LOCATION OF THE WATER RIGHT. IT IS NOT INTENDED TO PROVIDE INFORMATION RELATIVE TO THE LOCATION OF PROPERTY OWNERSHIP BOUNDARY LINES.

