


T16S, R18 & R19E, Sections 16, 17, 18, 19, 20, 24 & 30, WM Crook County, Oregon T-8827 Claim of Beneficial Use Map Primary Irrigation

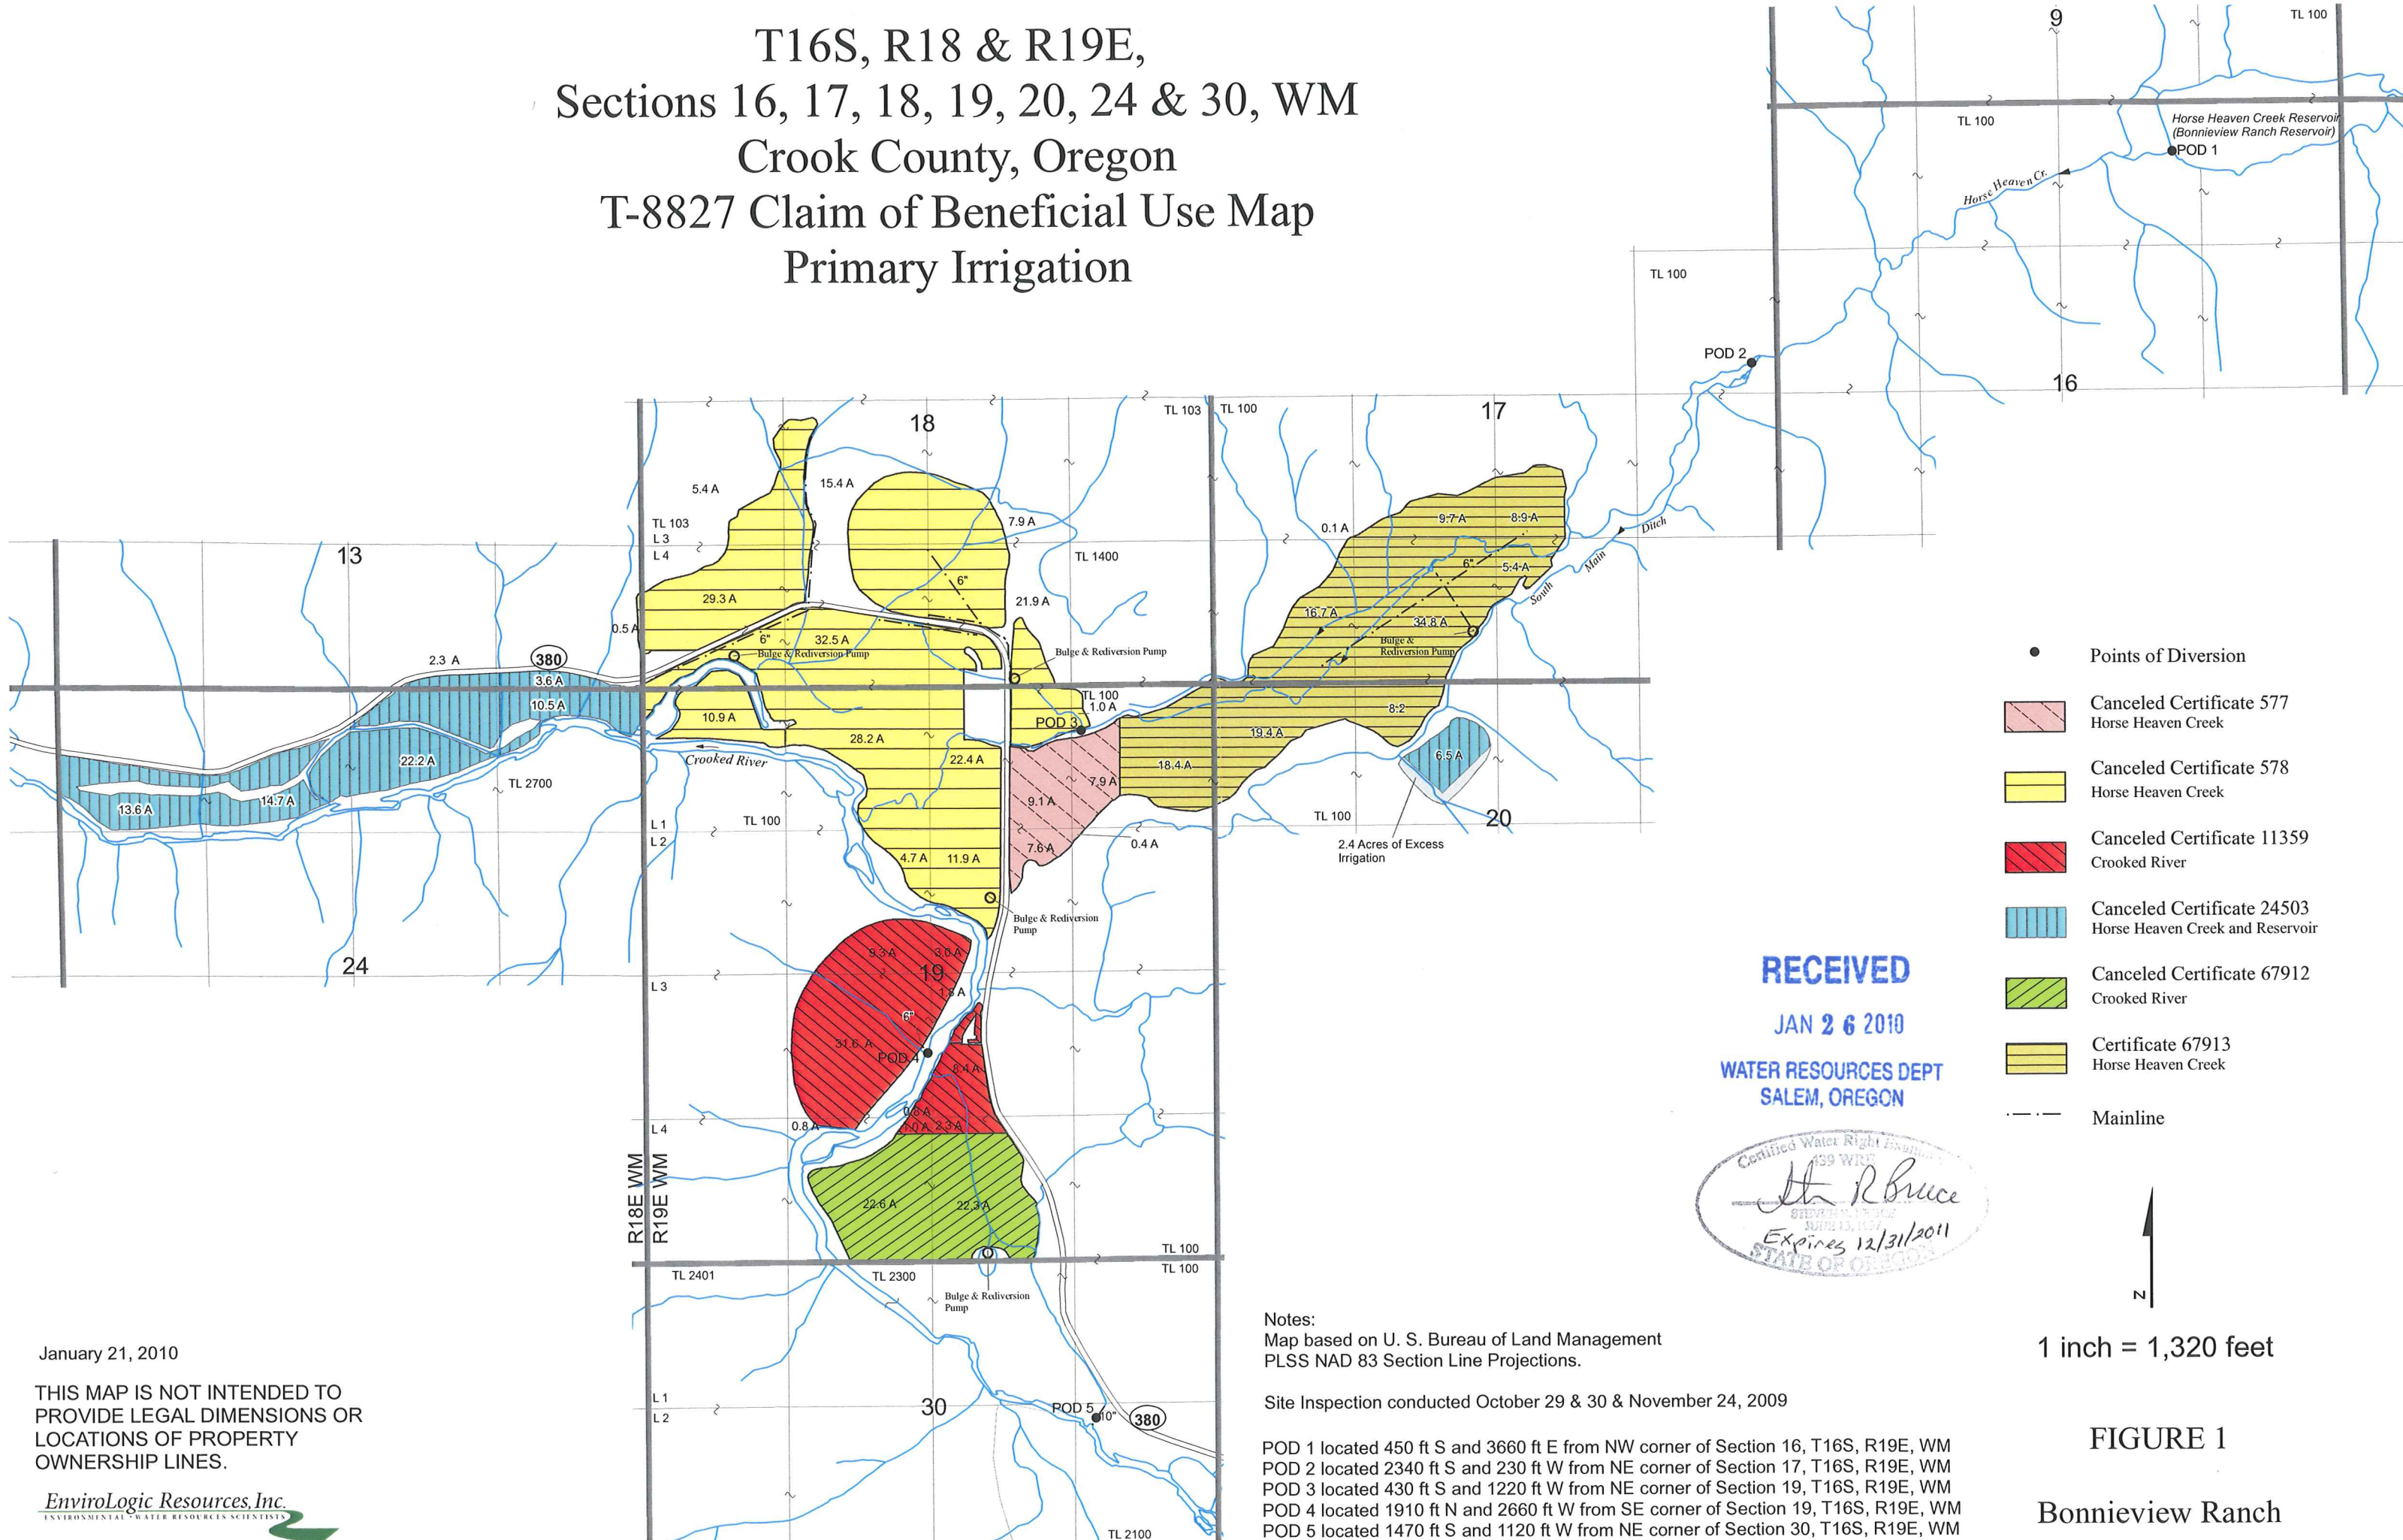

January 21, 2010

THIS MAP IS NOT INTENDED TO PROVIDE LEGAL DIMENSIONS OR LOCATIONS OF PROPERTY OWNERSHIP LINES.



Notes:
Map based on U. S. Bureau of Land Management
PLSS NAD 83 Section Line Projections.

Site Inspection conducted October 29 & 30 & November 24, 2009

POD 1 located 450 ft S and 3660 ft E from NW corner of Section 16, T16S, R19E, WM
POD 2 located 2340 ft S and 230 ft W from NE corner of Section 17, T16S, R19E, WM
POD 3 located 430 ft S and 1220 ft W from NE corner of Section 19, T16S, R19E, WM
POD 4 located 1910 ft N and 2660 ft W from SE corner of Section 19, T16S, R19E, WM
POD 5 located 1470 ft S and 1120 ft W from NE corner of Section 30, T16S, R19E, WM

1 inch = 1,320 feet

FIGURE 1

Bonnieview Ranch