

RECEIVED


APR 20 1998

WATER RESOURCES DEPT.
SALEM, OREGON


SECTION 5, T.4S., R.2W., W.M.
MARION COUNTY, OREGON

MAP BASE:
ASSESSORS MAP
1996 SCALED PHOTO
CERTIFICATE 23977

SCALE: 1" = 400'

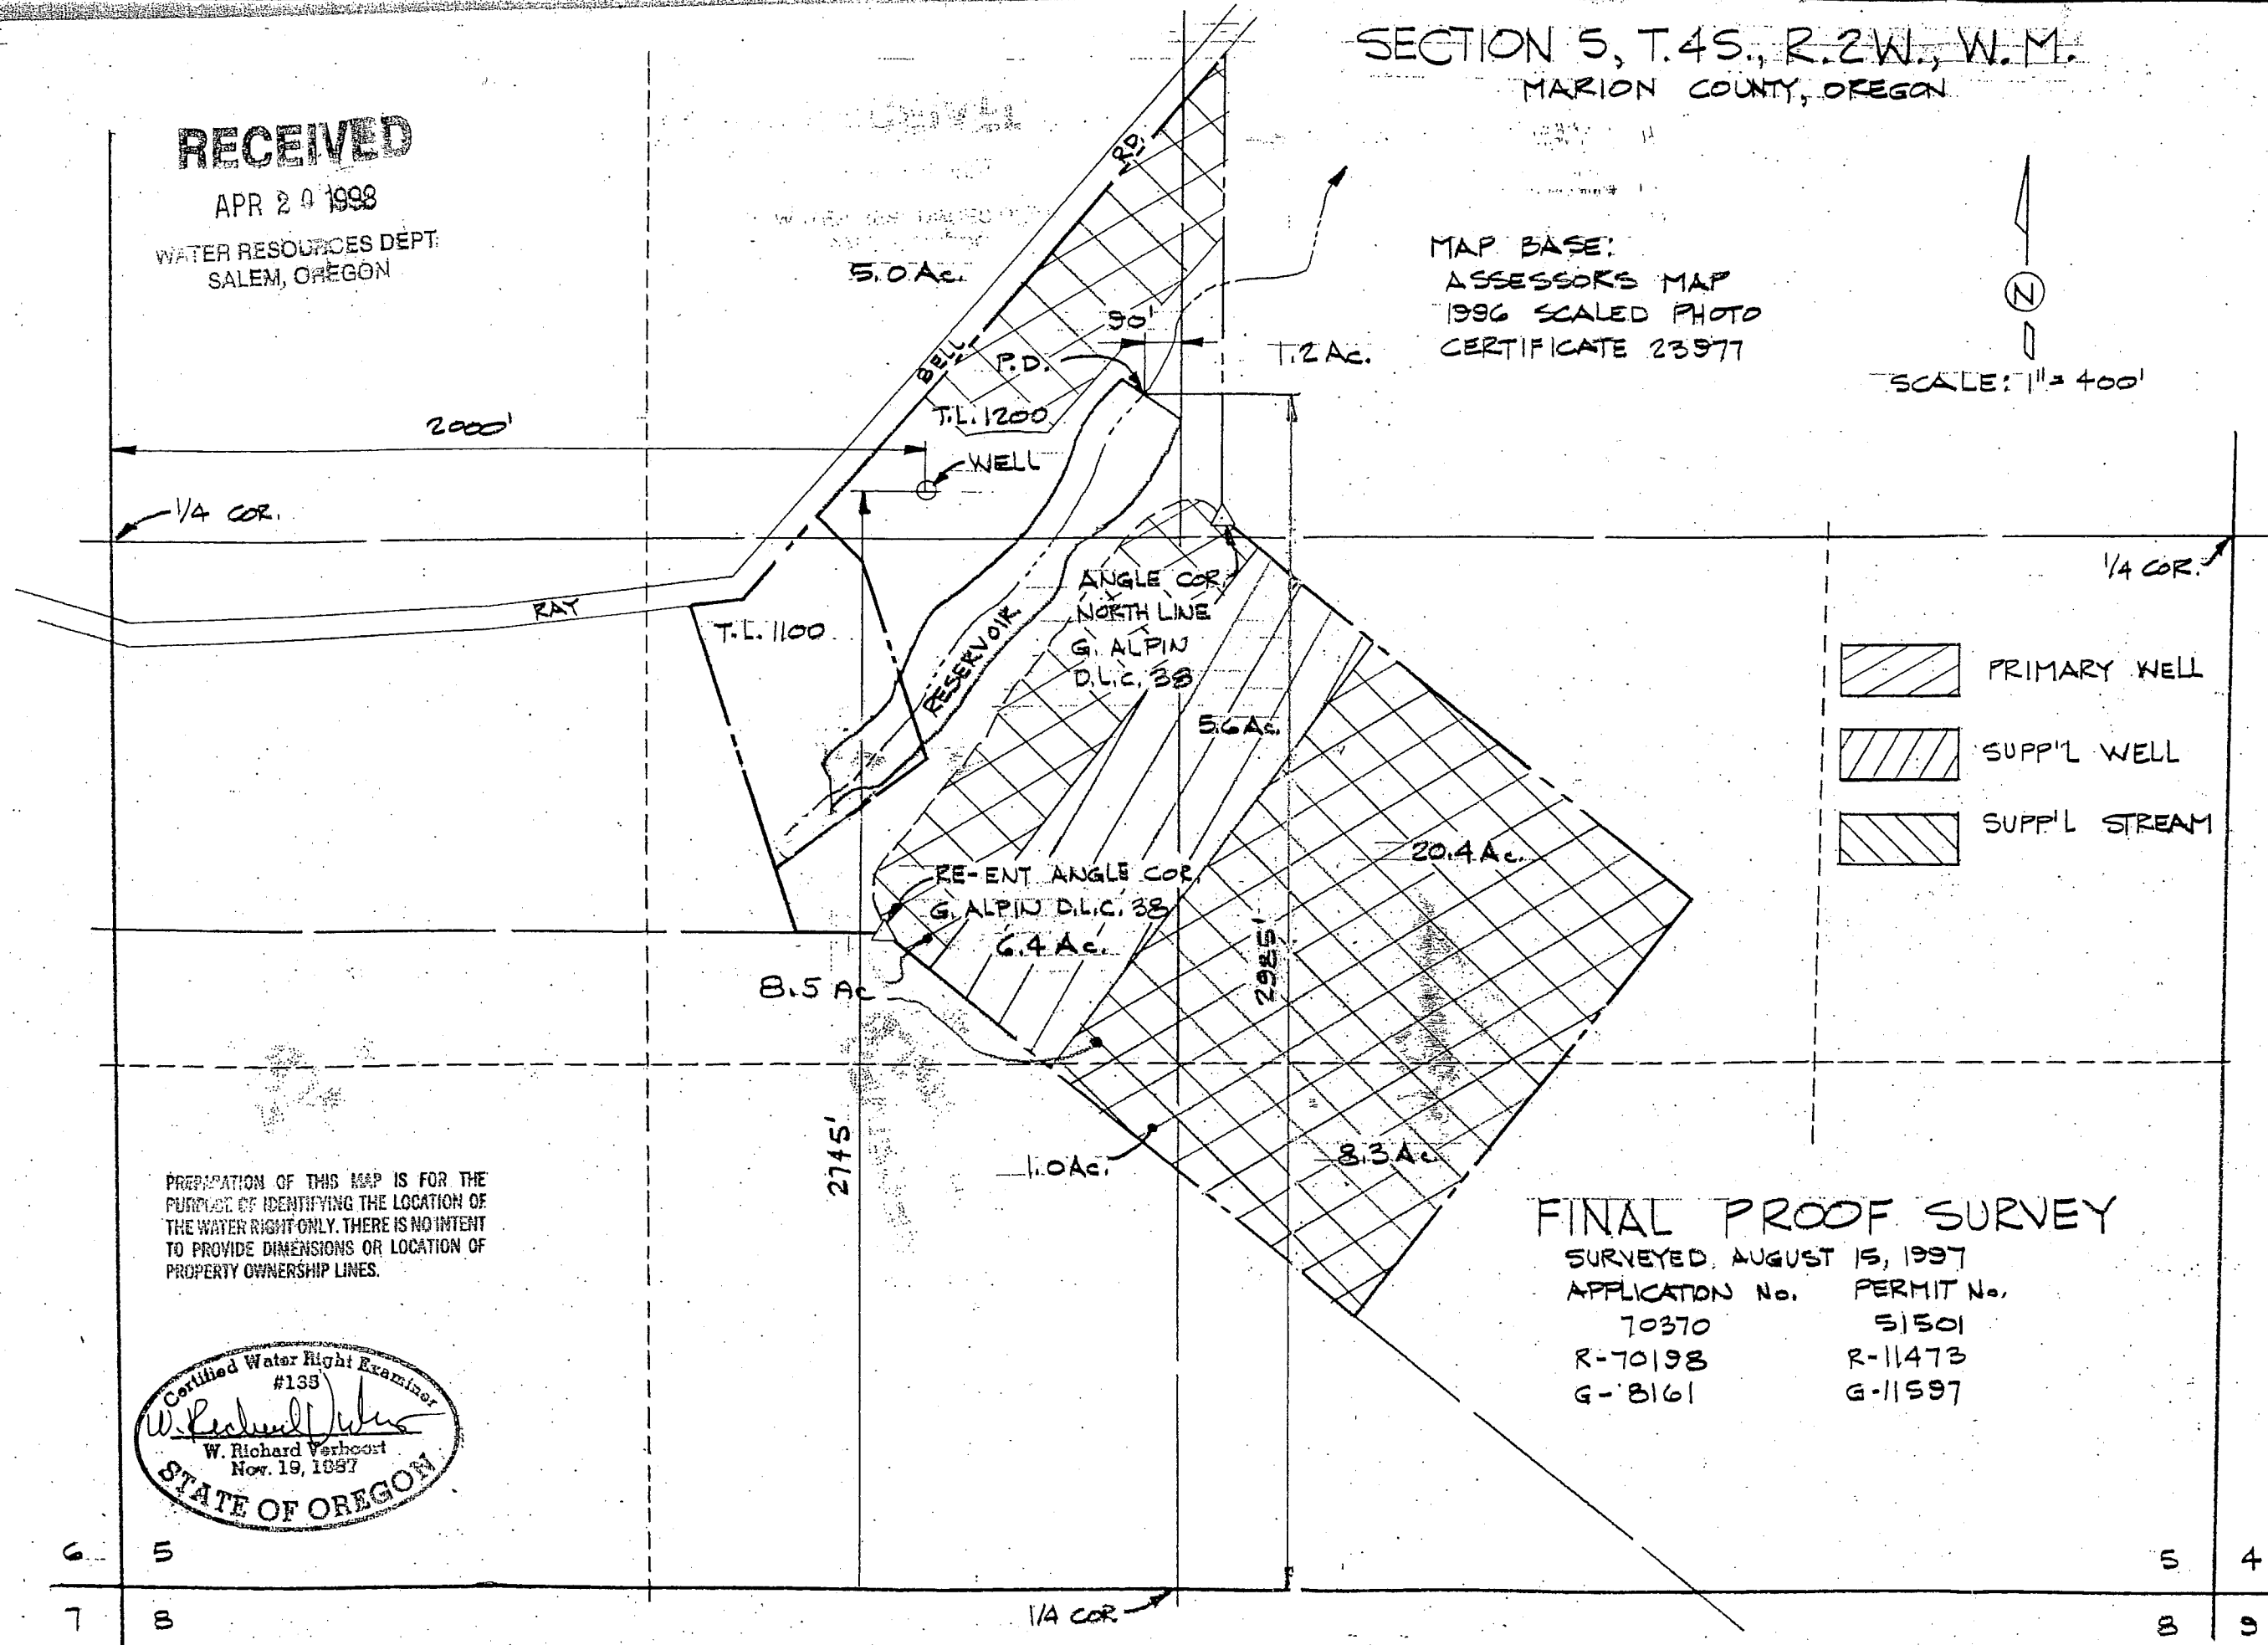

PREPARATION OF THIS MAP IS FOR THE
PURPOSE OF IDENTIFYING THE LOCATION OF
THE WATER RIGHT ONLY. THERE IS NO INTENT
TO PROVIDE DIMENSIONS OR LOCATION OF
PROPERTY OWNERSHIP LINES.

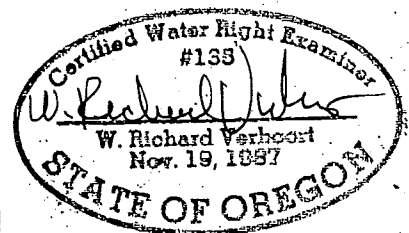

FINAL PROOF SURVEY

SURVEYED, AUGUST 15, 1997
 APPLICATION No. 70370 PERMIT No. 51501
 R-70198 R-11473
 G-8161 G-11597

H. RICHARD BRYANT
 4934 RAY BELL ROAD
 ST. PAUL, OR 97157

designed	by	date
WRV	WRV	2-11-98
drawn	JEL	2-11-98
checked	WRV	2-11-98

drawing no. 98-B-03
sheet no. 1/1

VERBOORT ENGINEERING
 AGRICULTURE-CIVIL-WATER RESOURCES
 HILLSBORO, OREGON