


CLAIM OF BENEFICIAL USE IN THE NAME OF BLANCO BOGGS, ALEX ELLS

APPLICATION #G-14563

PERMIT #G-13621 & AMENDMENT T-10499

SECTION 32 T.31S. R.15W. W.M.

CURRY COUNTY

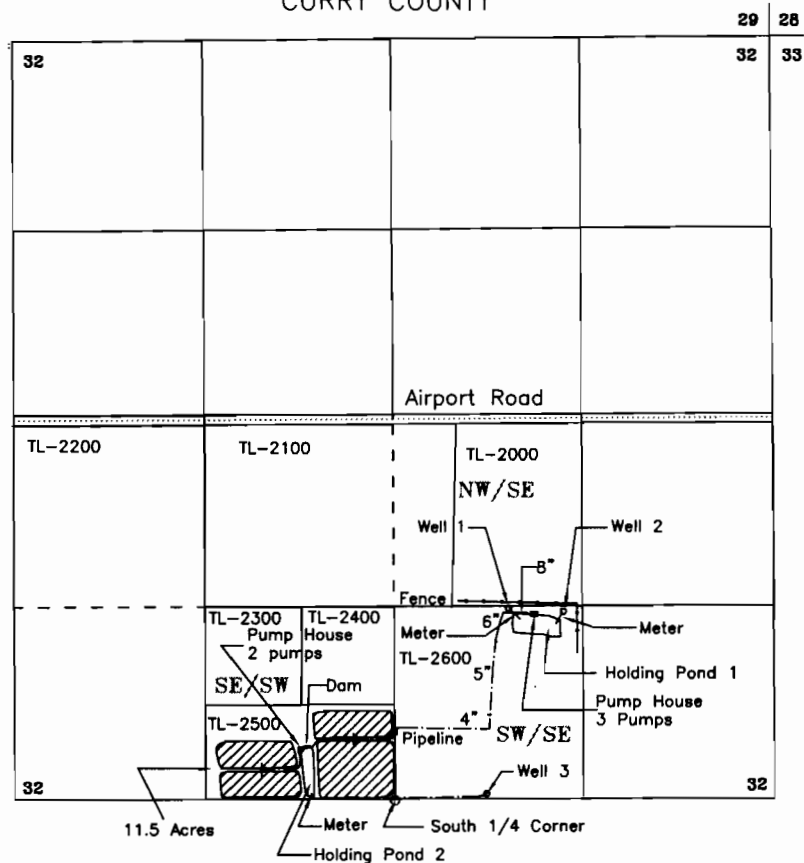

Well 1 - 1315 ft. North and 790 ft. East
from the South 1/4 Corner Section 32

Well 2 - 1290 ft. North and 1160 ft. East
from the South 1/4 Corner Section 32

Well 3 - 35 ft. North and 635 ft. East
from the South 1/4 Corner Section 32


 Cranberry Boggs - 11.5 Acres

Use of Water - Cranberry Use

BASE MAP: Bearing and distance for 1/4 1/4
section lines from Assessor Map (Curry Co. Web
site). Overlay on BLM Aerial Photo 5-31-2002
by assumed fit and orientation

Fence line shown is assumed property line per owner

This map is not intended to provide legal dimensions
or locations of property ownership lines.

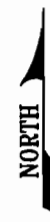

1 inch = 1320 feet

JORDAN ENGINEERING
460 JORDAN LANE
ROSEBURG, OR 97470
(541) 673-1931

12/15/2009 n.e.d.
G13621_cobu_map-c