



CLAIM OF BENEFICIAL USE MAP FOR CONSERVED WATER CW-58 IN THE NAME OF HALE FARMS LLC T3N, R29 AND 30E, WM, UMATILLA COUNTY SHEET 1 OF 3

RECEIVED

4/19/10

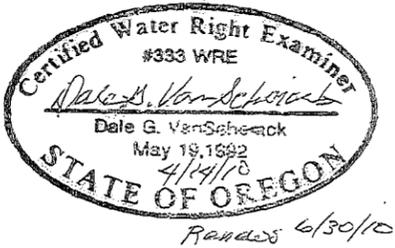

COLUMBIA RIVER DIVERSION POINT
LOCATED 2910ft NORTH AND 120ft
EAST FROM THE SW CORNER
SECTION 8, T5N, R30E, W.M.


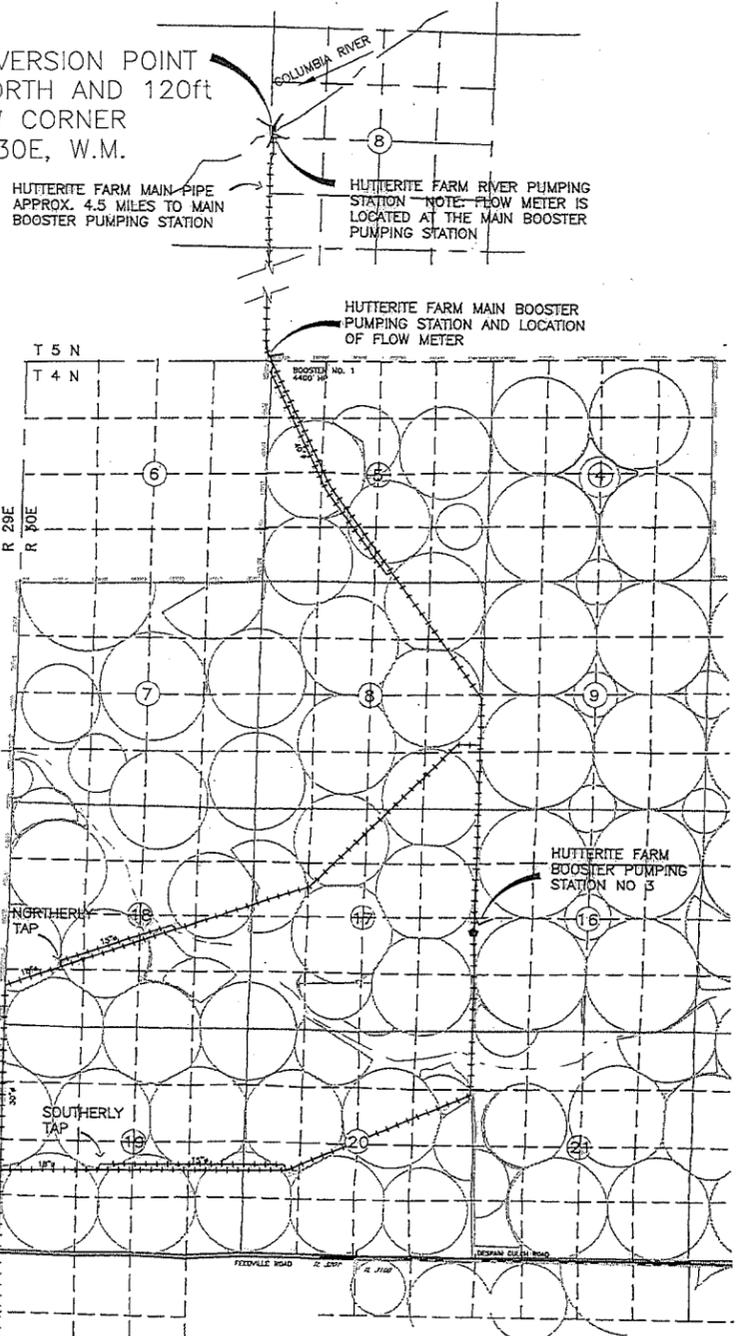


LOCATION OF WELLS

NOTE: THESE WELLS ARE POINTS OF APPROPRIATION FOR OTHER WATER RIGHTS ASSOCIATED WITH THE LAND BEING CLAIMED UNDER THIS COBU. THEY ARE NOT POINTS OF APPROPRIATION FOR THIS COBU.

- WELL 1 4340'N & 1830'W FROM S1/4 COR, SEC 7 T3N, R30E, W.M.
- WELL 2 2010'N & 1330'E FROM SW COR, SEC 6 T3N, R30E, W.M.
- WELL 3 1420'S & 40'E FROM W1/4 COR, SEC 7 T3N, R30E, W.M.
- WELL 4 180'N & 260'W FROM E1/4 COR, SEC 2 T3N, R29E, W.M.
- WELL 5 60'N & 590'W FROM SE COR, SEC 11 T3N, R29E, W.M.
- WELL 6 132'N & 2190'W FROM E1/4 COR, SEC 11 T3N, R29E, W.M.
- WELL 7 1010'S & 40'E FROM NW COR, SEC 12 T3N, R29E, W.M.
- WELL 8 1350'S & 50'W FROM NE COR NW 1/4 NW 1/4 SEC 14 T3N, R29E, W.M.
- SEIBEL WELL 380'N AND 3120'W FROM THE SE CORNER OF SEC 9 T3N, R29E, W.M.
- COPPINGER WELL 1 20'N & 1490'W FROM E1/4 COR, SEC 24 T3N, R29E, W.M.
- COPPINGER WELL 3 3960'N & 1320'W FROM SE COR, SEC 23 T3N, R29E, W.M.

NOTE: THERE IS A FLOW METER LOCATED AT THE WELL UNLESS THE WELL IS OUT OF SERVICE.

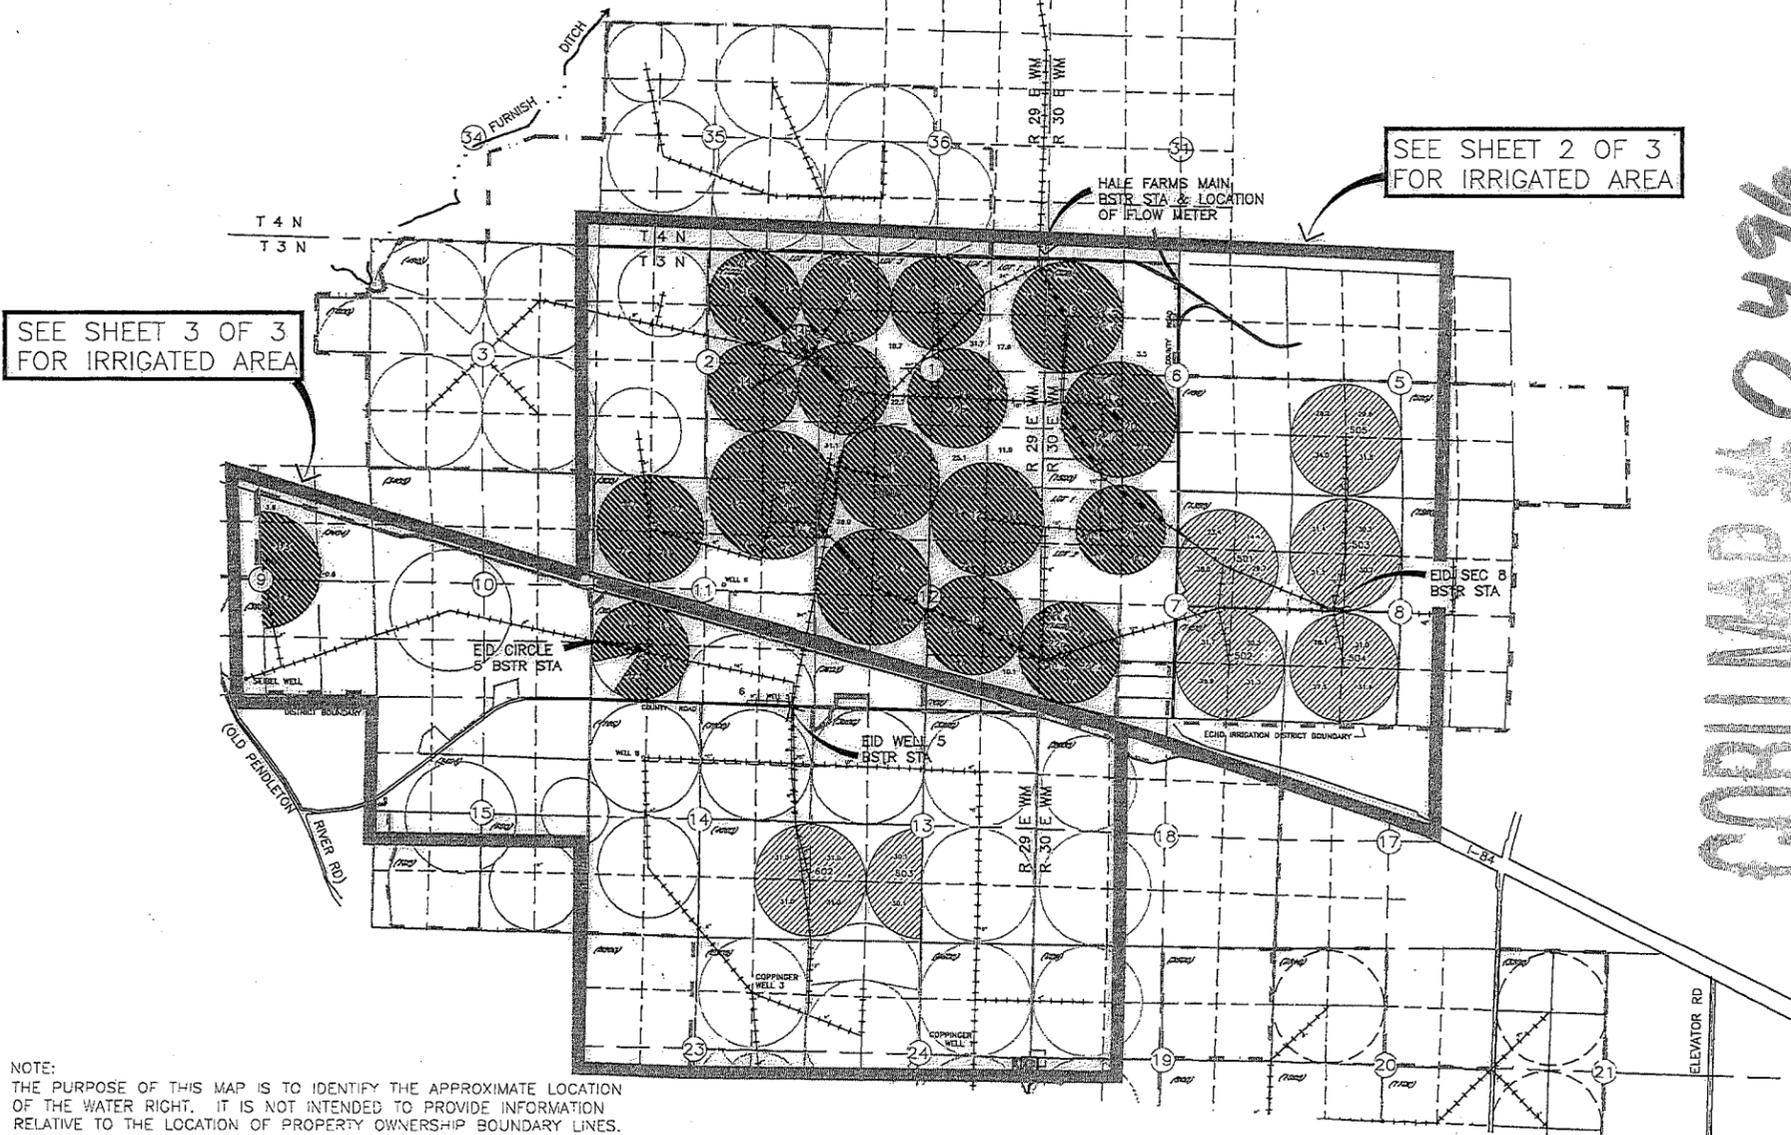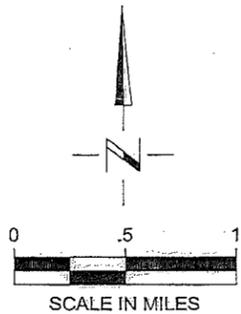


NOTE: THE PURPOSE OF THIS MAP IS TO IDENTIFY THE APPROXIMATE LOCATION OF THE WATER RIGHT. IT IS NOT INTENDED TO PROVIDE INFORMATION RELATIVE TO THE LOCATION OF PROPERTY OWNERSHIP BOUNDARY LINES.

CLAIM OF BENEFICIAL USE MAP FOR CONSERVED WATER CW-58 IN THE NAME OF HALE FARMS LLC

T3N, R29 AND 30E, WM, UMATILLA COUNTY

SHEET 2 OF 3

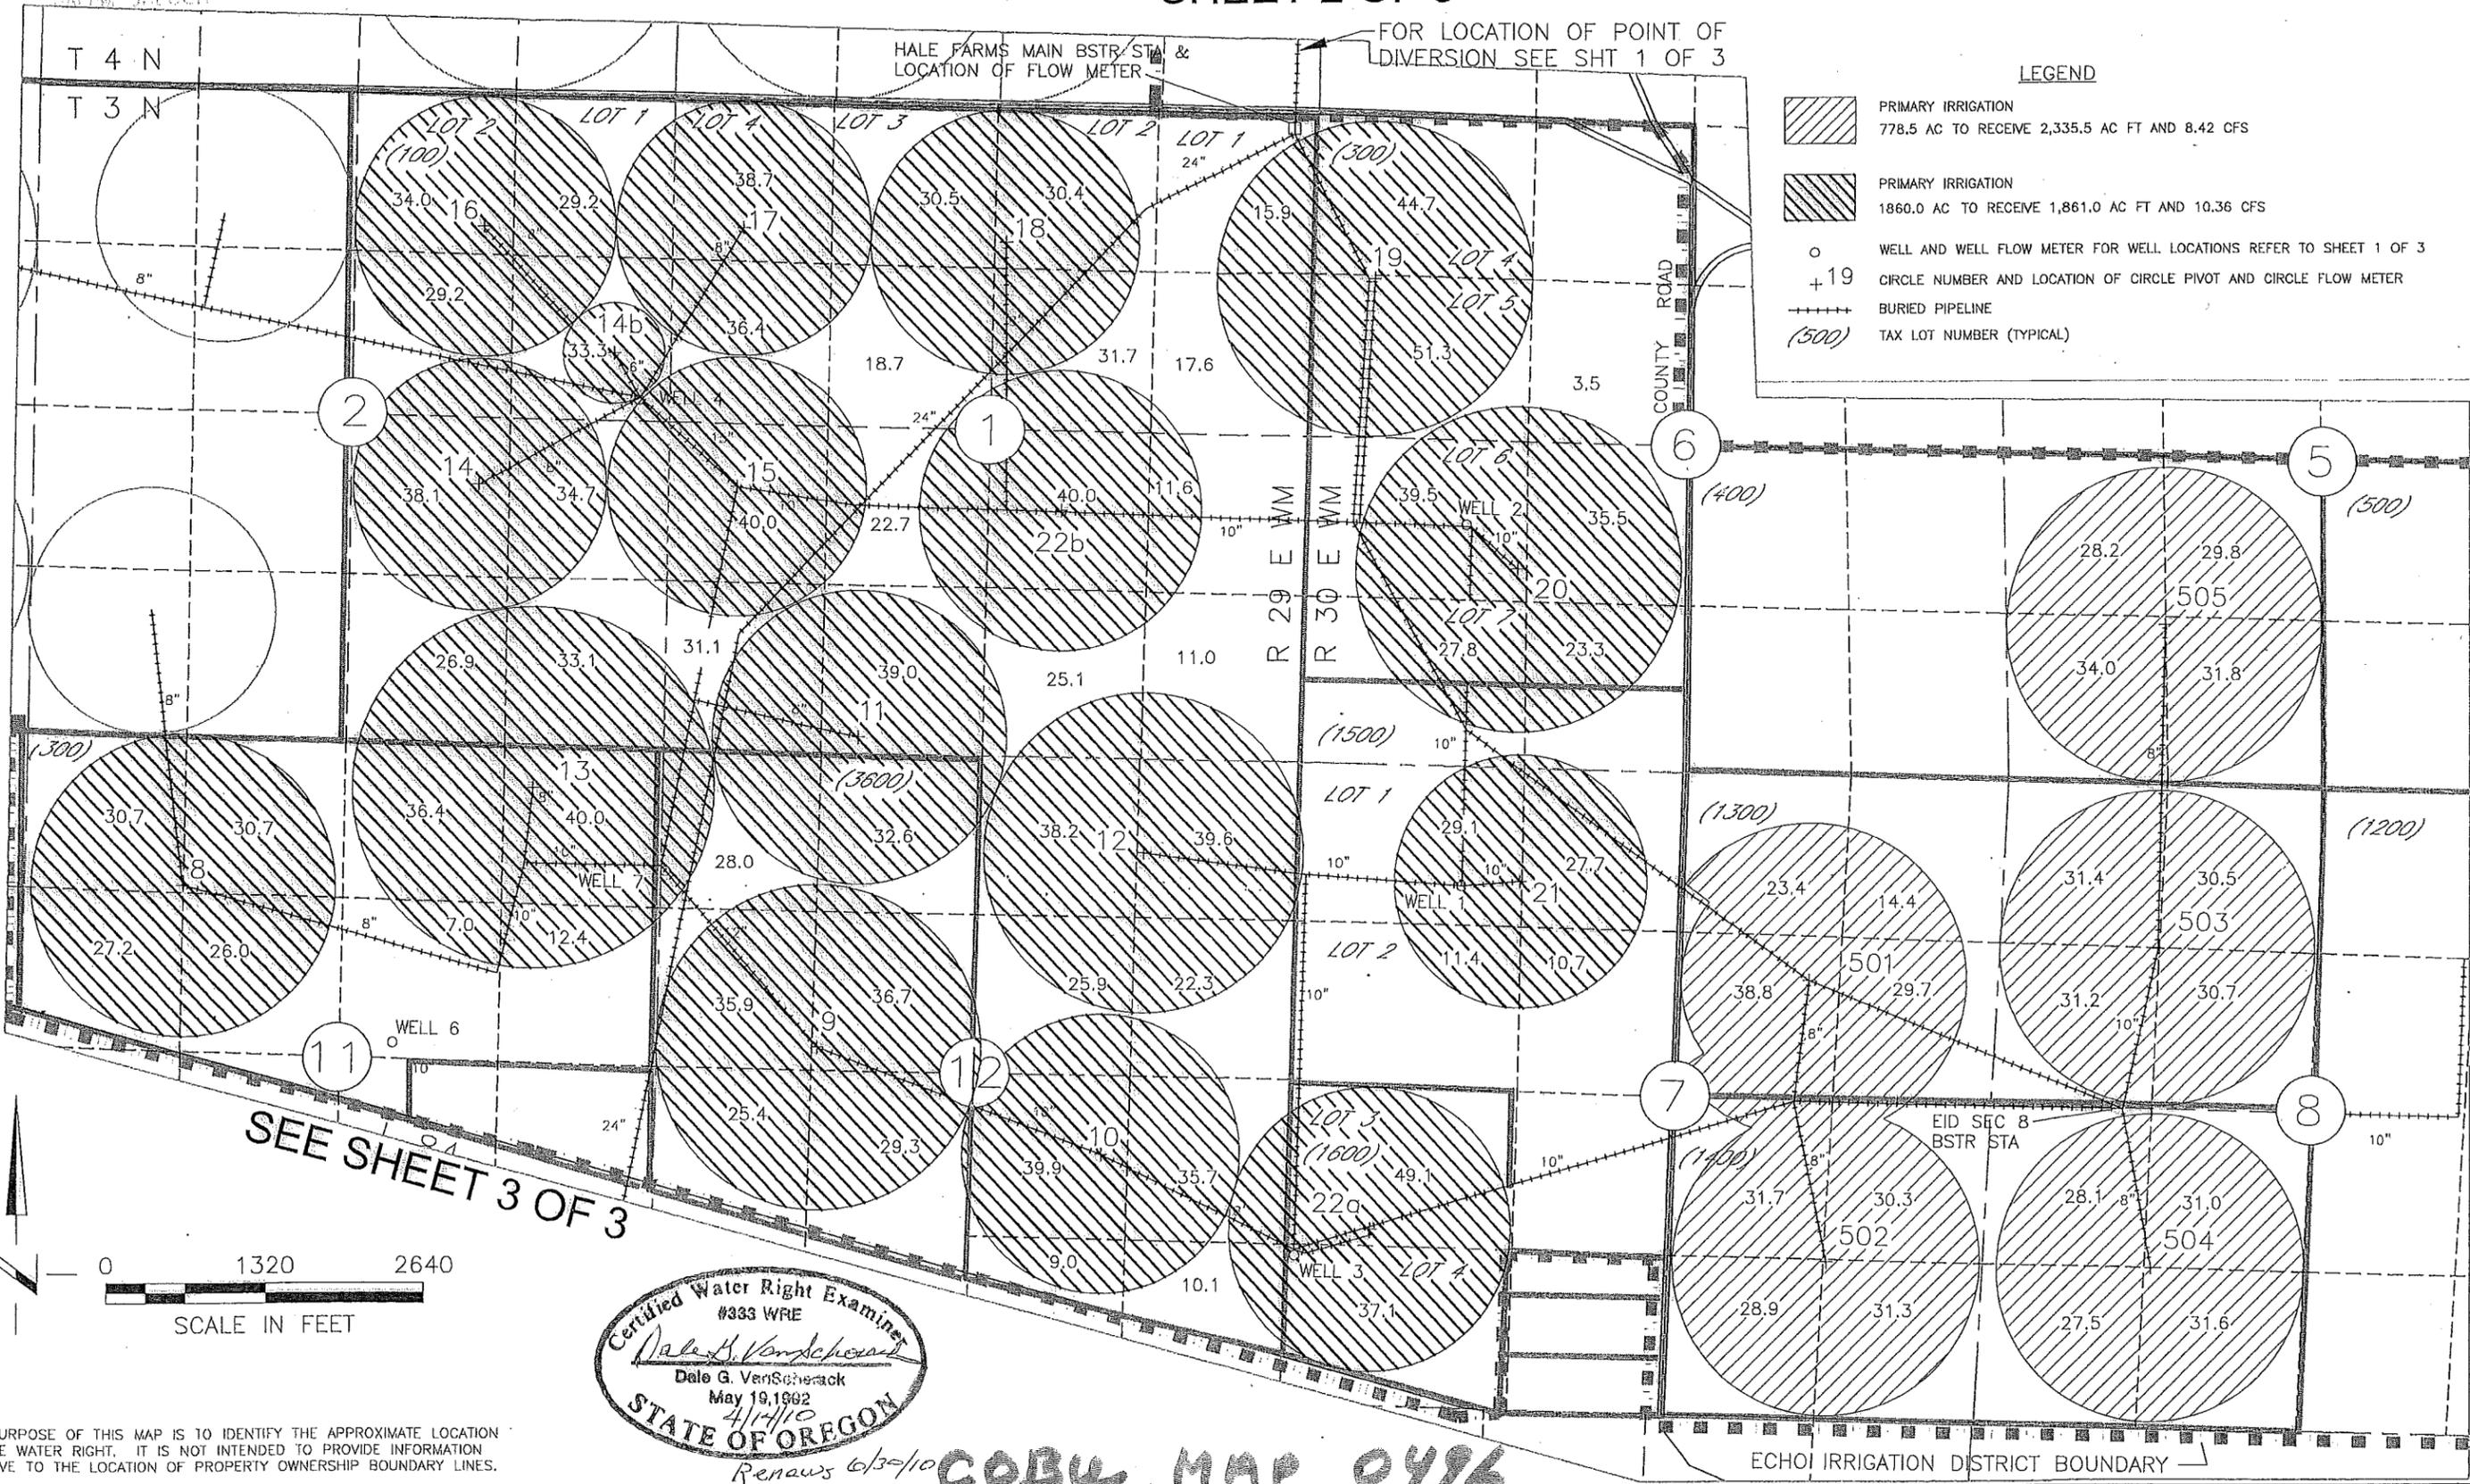

LEGEND

- PRIMARY IRRIGATION
778.5 AC TO RECEIVE 2,335.5 AC FT AND 8.42 CFS
- PRIMARY IRRIGATION
1860.0 AC TO RECEIVE 1,861.0 AC FT AND 10.36 CFS
- WELL AND WELL FLOW METER FOR WELL LOCATIONS REFER TO SHEET 1 OF 3
- CIRCLE NUMBER AND LOCATION OF CIRCLE PIVOT AND CIRCLE FLOW METER
- BURIED PIPELINE
- (500) TAX LOT NUMBER (TYPICAL)

SEE SHEET 3 OF 3



Certified Water Right Examiner
 #333 WRE
Dale G. VanScherack
 Dale G. VanScherack
 May 19, 1992
 4/14/10
STATE OF OREGON


Renews 6/30/10 COBU MAP 0476

NOTE:
THE PURPOSE OF THIS MAP IS TO IDENTIFY THE APPROXIMATE LOCATION OF THE WATER RIGHT. IT IS NOT INTENDED TO PROVIDE INFORMATION RELATIVE TO THE LOCATION OF PROPERTY OWNERSHIP BOUNDARY LINES.

CLAIM OF BENEFICIAL USE MAP FOR CONSERVED WATER CW-58 IN THE NAME OF HALE FARMS LLC T3N, R29 AND 30E, WM, UMATILLA COUNTY SHEET 3 OF 3

SEE SHEET 2 OF 3

FOR LOCATION OF POINT OF
DIVERSION SEE SHT 1 OF 3

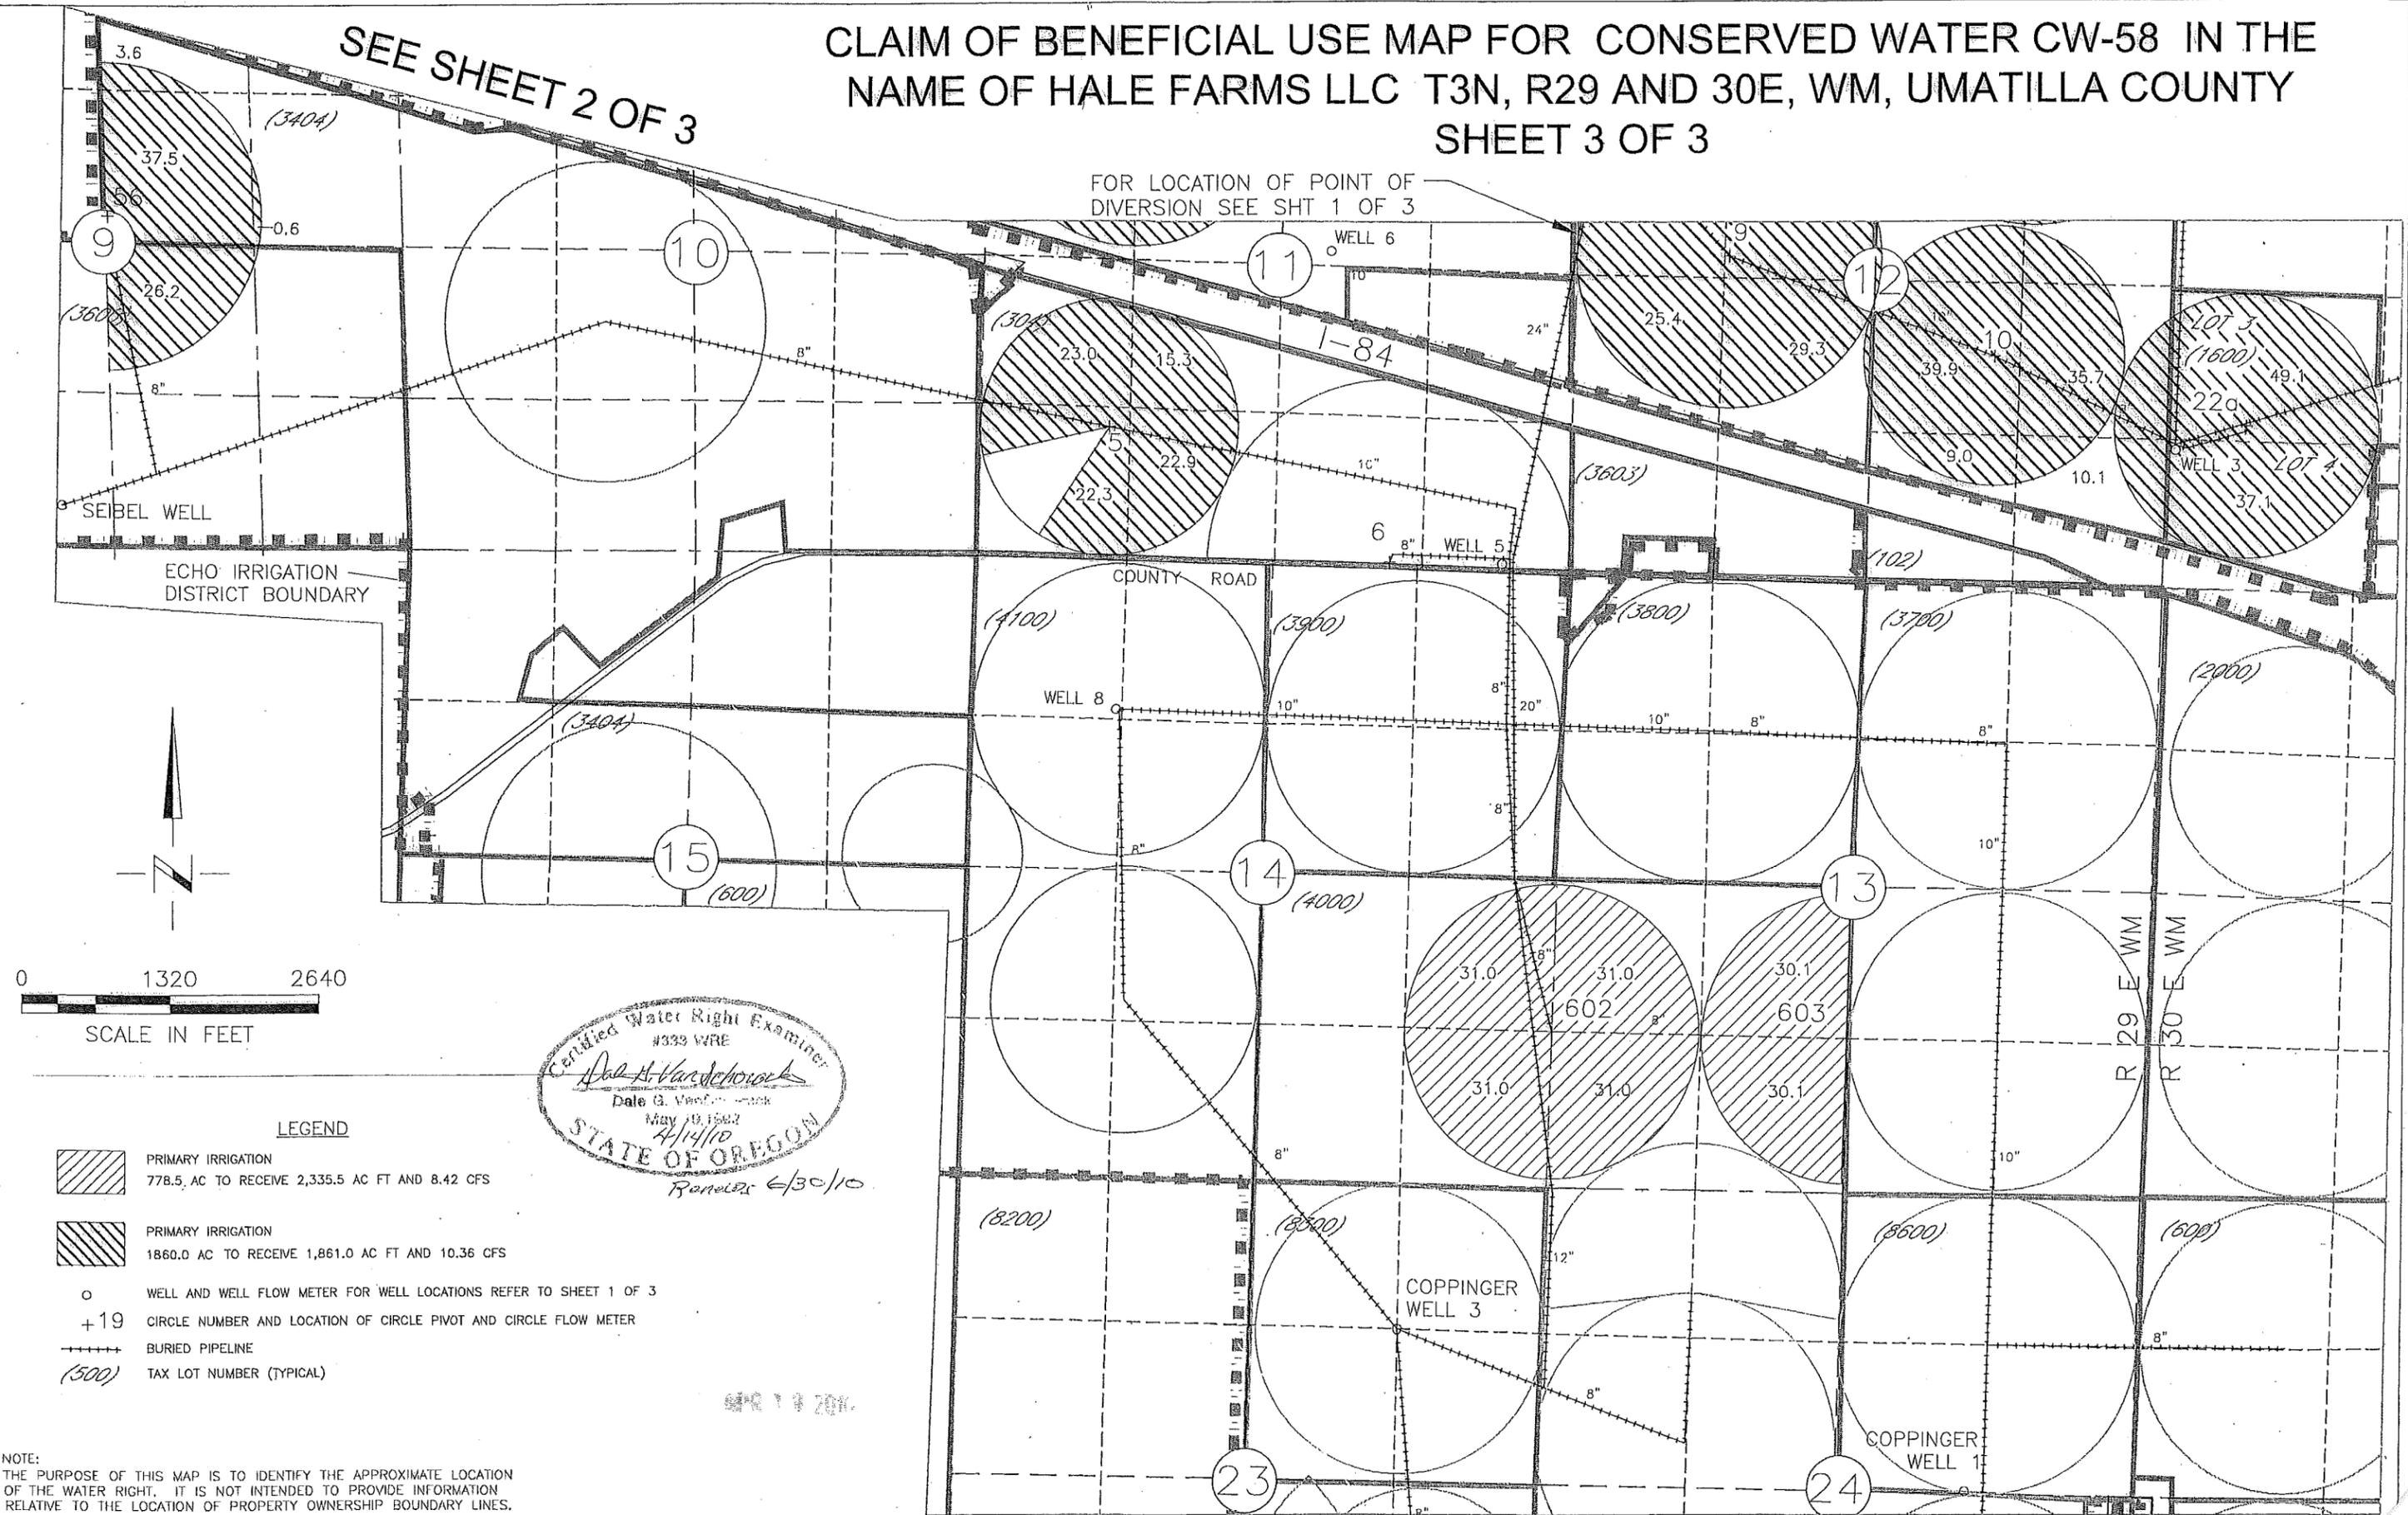

LEGEND

- PRIMARY IRRIGATION
778.5 AC TO RECEIVE 2,335.5 AC FT AND 8.42 CFS
- PRIMARY IRRIGATION
1860.0 AC TO RECEIVE 1,861.0 AC FT AND 10.36 CFS
- WELL AND WELL FLOW METER FOR WELL LOCATIONS REFER TO SHEET 1 OF 3
- CIRCLE NUMBER AND LOCATION OF CIRCLE PIVOT AND CIRCLE FLOW METER
- BURIED PIPELINE
- TAX LOT NUMBER (TYPICAL)

Certified Water Right Examiner
 #333 WRE
Dale G. Vandenhorst
 Dale G. Vandenhorst
 May 19, 1982
 4/14/10
STATE OF OREGON
 Renewed 6/30/10


NOTE:
THE PURPOSE OF THIS MAP IS TO IDENTIFY THE APPROXIMATE LOCATION
OF THE WATER RIGHT. IT IS NOT INTENDED TO PROVIDE INFORMATION
RELATIVE TO THE LOCATION OF PROPERTY OWNERSHIP BOUNDARY LINES.

COBUL MAP 0496