


T. 23 S. R. 7 W. W. M.

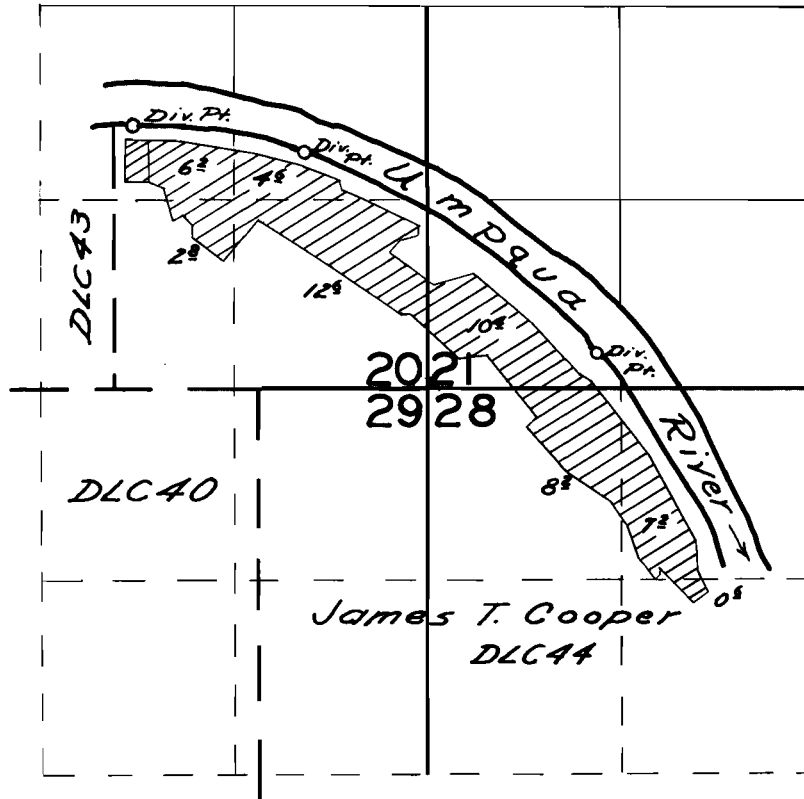

**FINAL PROOF SURVEY**


UNDER

Application No. *25701* Permit No. *20139*  
IN NAME OF

*P. W. George*

Surveyed *July 1, 1956* by *C. O. Bactels*

**APPLICATION FOR TRANSFER  
CHANGE IN POINT OF DIVERSION  
CERTIFICATE 79477  
TOWNSHIP 23 SOUTH, RANGE 7 WEST, W.M.  
DOUGLAS COUNTY, OREGON**

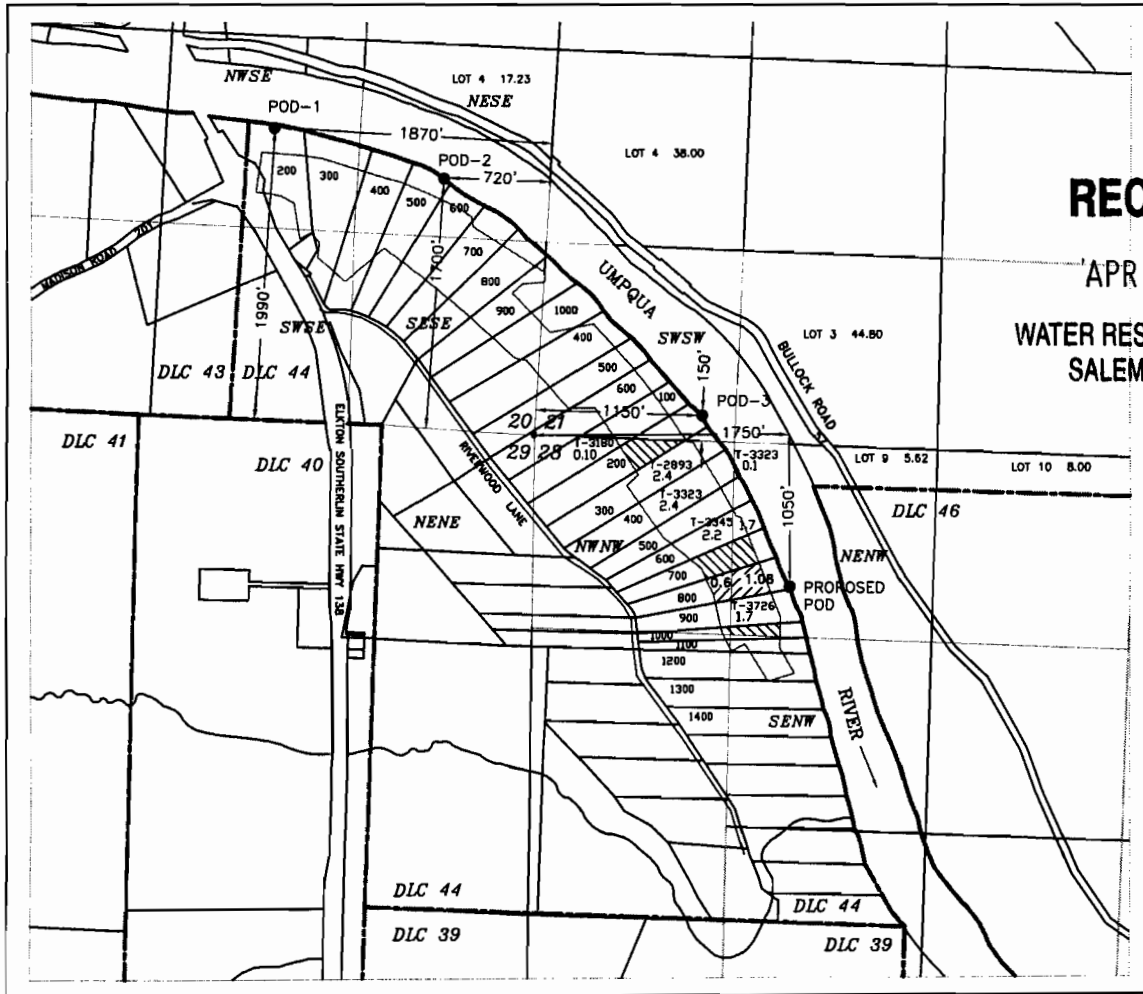


**RECEIVED**



APR 30 2009

WATER RESOURCES DEPT  
SALEM, OREGON

**APPLICANT:**  
Victor D. & Vicky S. Newfield  
601 Davis Place  
Mt. Shasta, CA 96067

CERTIFICATE 79477 - APPLICATION 25701 - PERMIT 20139

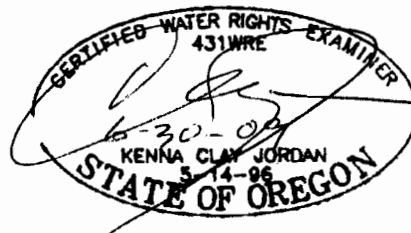

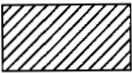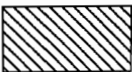-  Land to be irrigated by proposed POD 1.68 Ac.
-  Remaining Right  
1.04 Ac. NENE Sec. 28\*  
2.08 Ac. NWNW Sec. 28\*

Base map - Douglas County GIS with 1980 corrected Final Proof Map overlay and 2005 FSA aerial photo overlay

\* Per superseding Final Proof Survey Map dated 6/2/1980 less previous transfers and this transfer application

NOTE: Certificate was not corrected to match superseding Final Proof Survey Map

Scale

1" = 1320'

**JORDAN ENGINEERING**  
460 JORDAN LANE  
ROSEBURG, OR 97471  
(541) 673-1931

Revised 4/27/2009 n.e.d.

This map is not intended to provide legal dimensions or locations of property ownership lines