


RECEIVED

DEC - 7 1993

WATER RESOURCES DEPT.
SALEM, OREGON

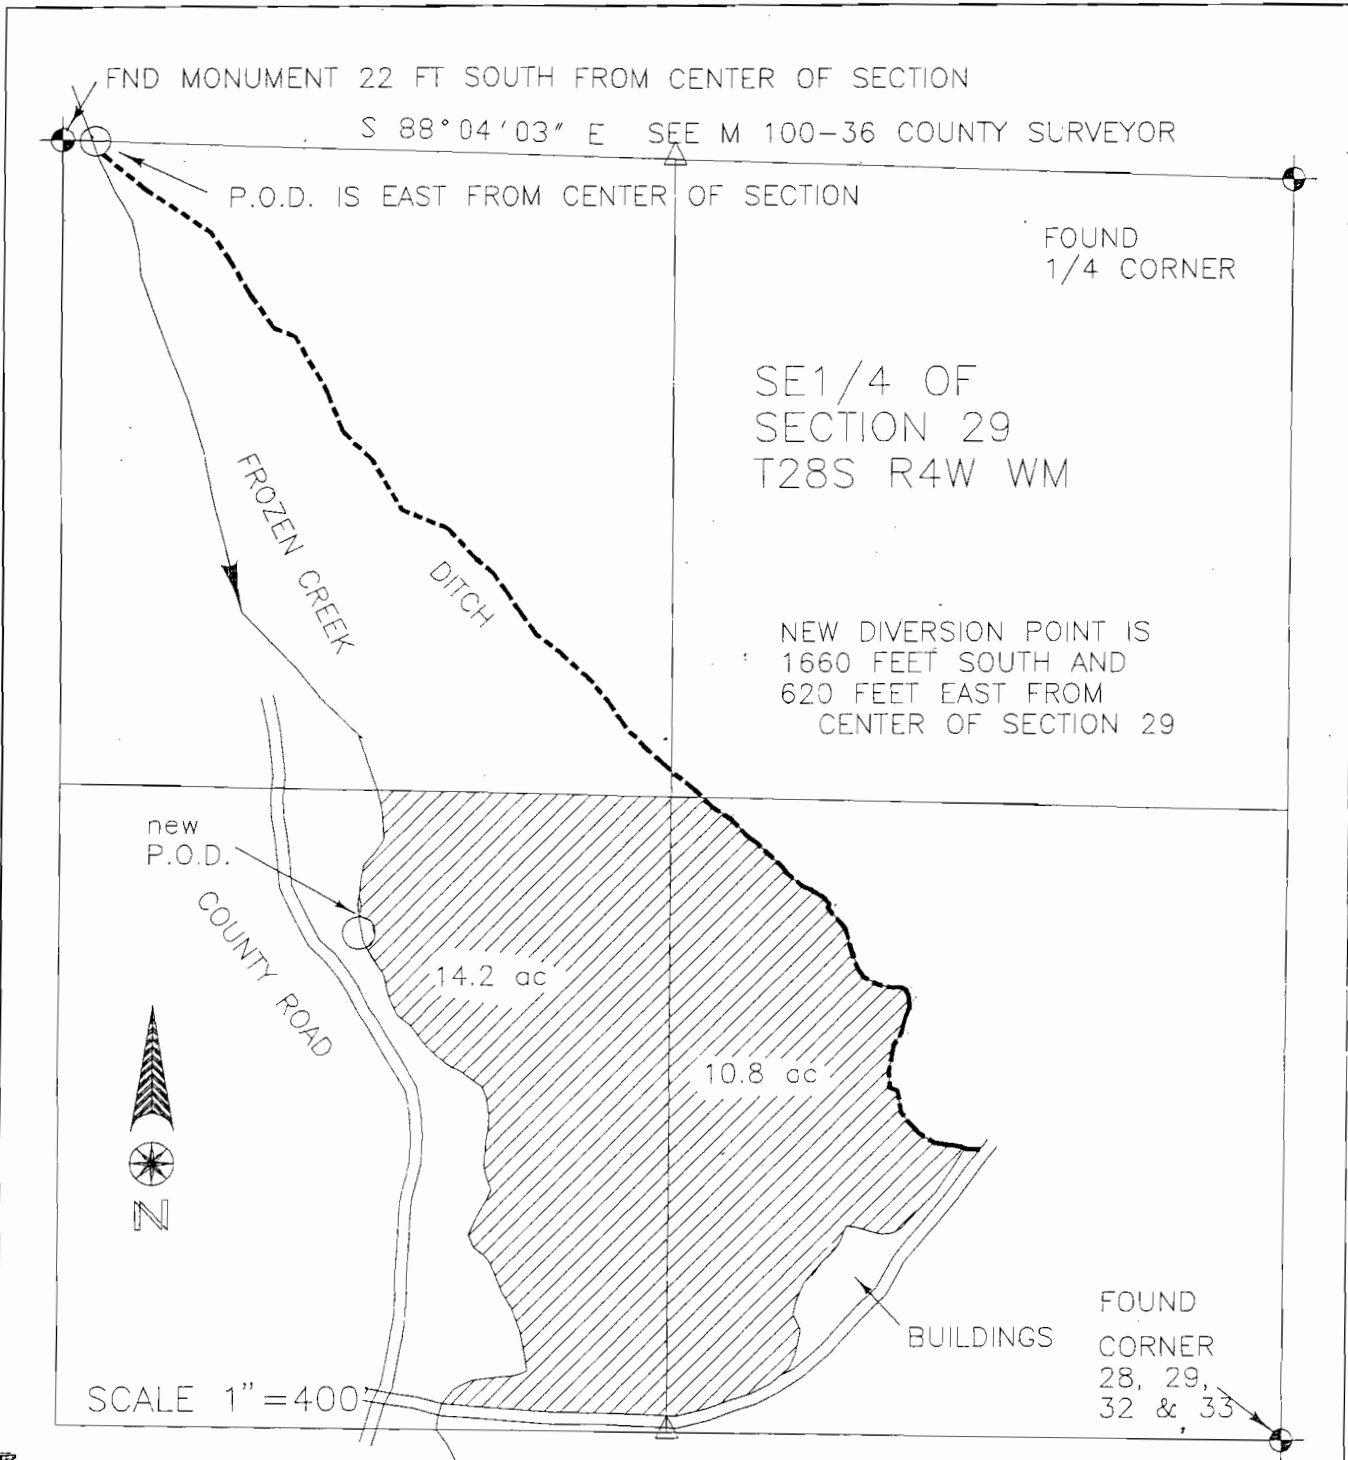

FINAL PROOF SURVEY FOR T-6684
FOR ADDITIONAL POINT OF DIVERSION
FOR EDWARD MacDONALD

BY: WILLIAM J. RUPPERT
P.O. BOX 1564

MYRTLE CREEK, OR 97457 DATE NOVEMBER 14, 1993

