


T.19S., R.17&18E., W. M.

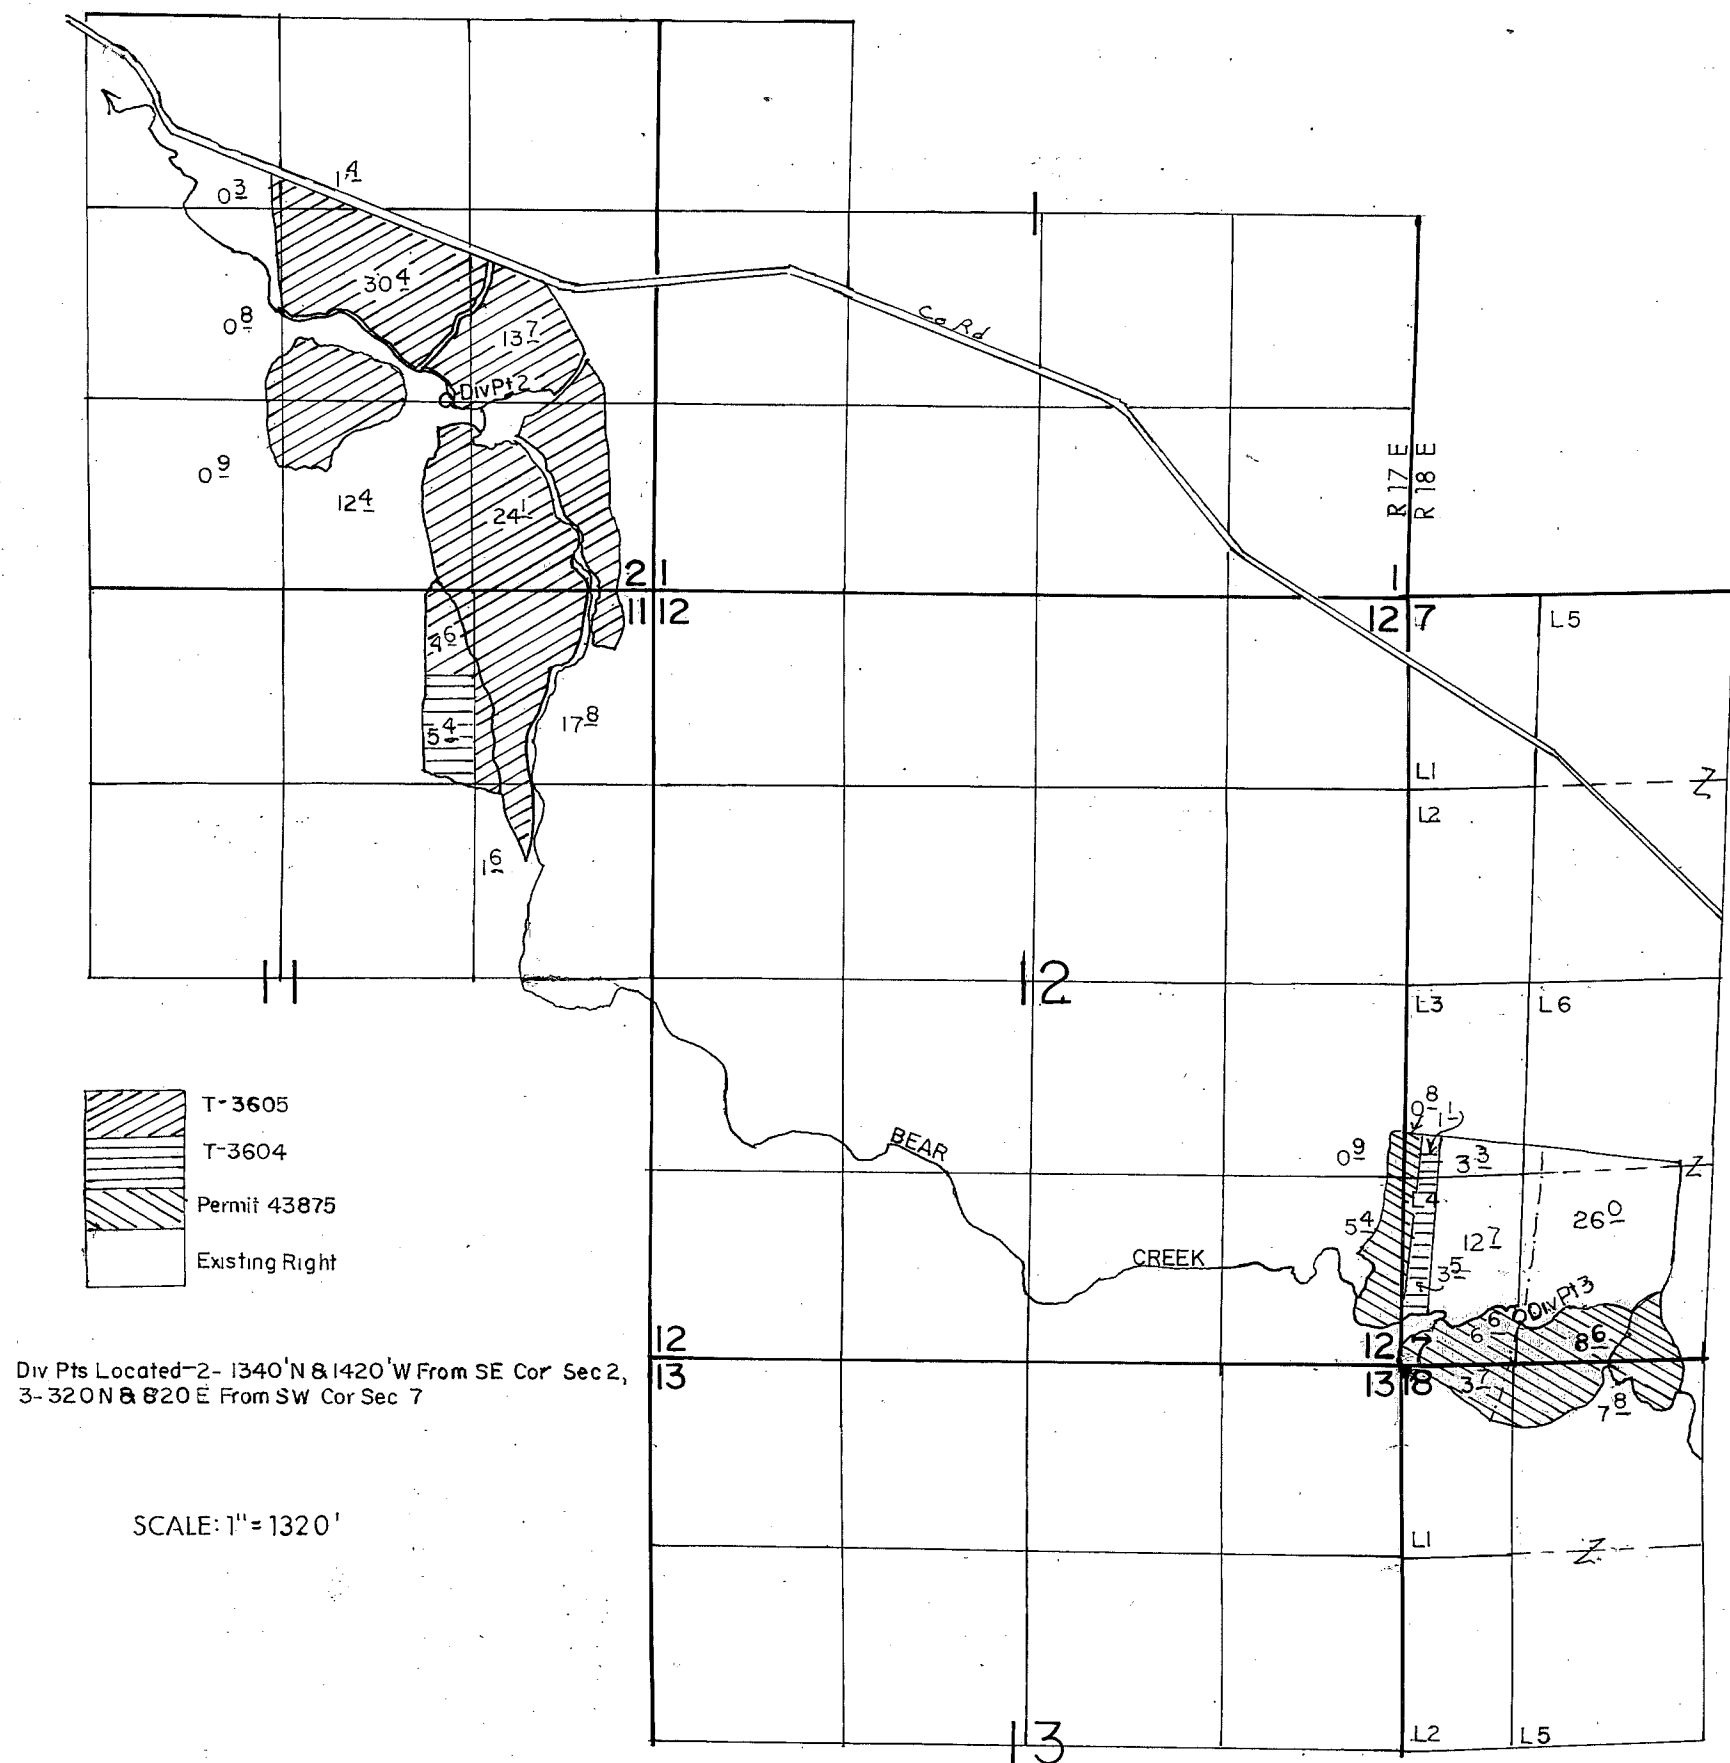

FINAL PROOF SURVEY
UNDER

Application No. 55566..... Permit No. 43875.....

TRANSFERS NO 3604 - 3605

IN NAME OF

Wm. R McCormack

Surveyed March 23, 1990 By BW Bishop